USE TYPEWRITER OR BALL POINT PEN-PRESS FIRMLY, PRINT CLEARLY.

WATER WELL RECORD
KSA 82a-1201-1215

Kansas Department of Health and Environment-Division of Environment
(Water well Contractors)
Topeka, Kansas 66620

1. Location of well:	County: Sedgwick	Fraction: 1/4 SW 1/4 SE 1/4	Section number: 10	Township number: T 28 S	Range number: R 2 E (W)

2. Distance and direction from nearest town or city: 3W. of Schulte
Street address of well location if in city: on 39th St on

3. Owner of well: Clarence Theme
R.R. or street: R.R. #1
City, state, zip code: Viola, Kansas

4. Locate with "X" in section below:

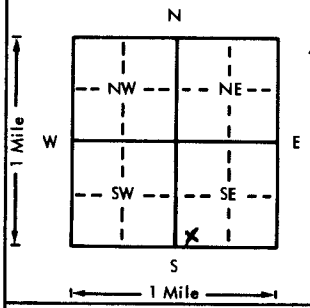

Sketch map: the South Side of the road Schulte, Kansas

6. Bore hole dia. 11 in. Completion date 5-31-76
Well depth 65 ft.

7. __ Cable tool ✓ Rotary __ Driven __ Dug
__ Hollow rod __ Jetted __ Bored __ Reverse rotary

8. Use: ✓ Domestic __ Public supply __ Industry
__ Irrigation __ Air conditioning __ Stock
__ Lawn __ Oil field water __ Other

9. Casing: Material STYRENE Height: Above (Below) or below
Threaded __ Welded GL Surface 12 in.
RMP ✓ PVC __ Weight __ lbs./ft.
Dia. 5 in. to 65 ft. depth Wall Thickness: inches or
Dia. __ in. to __ ft. depth gage No. 200

5. Type and color of material	From	To
Topsoil	0	3
Clay	3	14
Fine Sand	14	18
Shale	18	65
(Use a second sheet if needed)		

10. Screen: Manufacturer's name SUNFLOWER PLASTIC
Type STYRENE Dia. 5"
Slot/gauze .06 Length 45'
Set between 20 ft. and 65 ft.
__ ft. and __ ft.
Gravel pack? YES Size range of material 1/4 - 1/8"

11. Static water level: mo./day/yr.
16 ft. below land surface Date 5-31-76

12. Pumping level below land surfaces:
__ ft. after __ hrs. pumping __ g.p.m.
__ ft. after __ hrs. pumping __ g.p.m.
Estimated maximum yield __ g.p.m.

13. Water sample submitted: mo./day/yr.
__ Yes __ No Date

14. Well head completion: capped
__ Pitless adapter 12 Inches above grade

15. Well grouted? YES
With: __ Neat cement __ Bentonite ✓ Concrete
Depth: From 40" to 14 ft.

16. Nearest source of possible contamination: Septic Tank
ft. 100 Direction SE Type
Well disinfected upon completion? ✓ Yes __ No

17. Pump: ✓ Not installed
Manufacturer's name
Model number HP Volts
Length of drop pipe ft. capacity g.p.m.
Type:
__ Submersible __ Turbine
__ Jet __ Reciprocating
__ Centrifugal __ Other

T 28 R 2 E (W) Sec 10 1/4 SW 1/4 SE 1/4

18. Elevation:
Topography:
__ Hill
✓ Slope
__ Upland
__ Valley

19. Remarks:

20. Water well contractor's certification:
This well was drilled under my jurisdiction and this report is true to the best of my knowledge and belief.
HARP WELL & PUMP 236
Business name License No.
Address WICHITA, KANSAS
Signed M. Arnold Date 8-2-76
Authorized representative

Forward the white, blue and pink copies to the Department of Health and Environment

Form WWC-5

MI-1023