USE TYPEWRITER OR BALL POINT PEN-PRESS FIRMLY, PRINT CLEARLY.

WATER WELL RECORD
KSA 82a-1201-1215

Kansas Department of Health and Environment-Division of Environment
(Water well Contractors)
Topeka, Kansas 66620

1. Location of well: County: Sedgwick | Fraction: 1/4 SE 1/4 SW 1/4 | Section number: 12 | Township number: T 28 S | Range number: R 2 E W

2. Distance and direction from nearest town or city: 13550 W. 39 So.
Street address of well location if in city: Wichita, Ks.

3. Owner of well: Ed Bridwell St.
R.R. or street: 2625 So. West St.
City, state, zip code: Wichita, Kansas

4. Locate with "X" in section below: Sketch map:

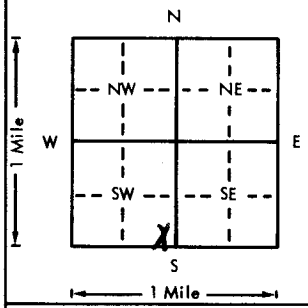

6. Bore hole dia. 6 5/8 in. Completion date
Well depth 95 ft. 10-3-25

7. __ Cable tool X Rotary __ Driven __ Dug
__ Hollow rod __ Jetted __ Bored __ Reverse rotary

8. Use: X Domestic __ Public supply __ Industry
__ Irrigation __ Air conditioning __ Stock
__ Lawn __ Oil field water __ Other

9. Casing: Material Steel Height Above or below
Threaded __ Welded X Surface 12 in.
RMP X PVC __ Weight lbs./ft.
Dia. 5 in. to 95 ft. depth Wall Thickness: inches or
Dia. __ in. to __ ft. depth gage No. .200

5. Type and color of material	From	To
Topsoil and Sandy Clay	0	10
Blue Shale	10	95

10. Screen: Manufacturer's name Sunflower Plastic
Type Stream Dia. 5"
Slot/gauze .050 Length 75'
Set between 20 ft. and 95 ft.
ft. and ft.
Gravel pack? Yes Size range of material 1/4-1/8"

11. Static water level: mo./day/yr.
20 ft. below land surface Date 10-3-25

12. Pumping level below land surfaces:
ft. after hrs. pumping g.p.m.
ft. after hrs. pumping g.p.m.
Estimated maximum yield g.p.m.

13. Water sample submitted: mo./day/yr.
__ Yes __ No Date

14. Well head completion: capped
__ Pitless adapter 12 Inches above grade

15. Well grouted? yes
With: __ Neat cement __ Bentonite X Concrete
Depth: From 40" to 14 ft.

16. Nearest source of possible contamination:
ft. 100 Direction SE Type Septic Tank
Well disinfected upon completion? X Yes __ No

17. Pump: X Not installed
Manufacturer's name
Model number HP Volts
Length of drop pipe ft. capacity g.p.m.
Type:
__ Submersible __ Turbine
__ Jet __ Reciprocating
__ Centrifugal __ Other

(Use a second sheet if needed)

18. Elevation:
Topography:
X Hill
__ Slope
__ Upland
__ Valley

19. Remarks:

20. Water well contractor's certification:
This well was drilled under my jurisdiction and this report is true to the best of my knowledge and belief.
Harp Well & Pump 236
Business name License No.
Address Wichita Kansas
Signed M. Arnold Date 10-6-25
Authorized representative

28 - 2 W 12 SE SE SW
T R Sec 1/4 1/4 1/4

Forward the white, blue and pink copies to the Department of Health and Environment

Form WWC-5

MI-1023