USE TYPEWRITER OR BALL POINT PEN-PRESS FIRMLY, PRINT CLEARLY.

WATER WELL RECORD
KSA 82a-1201-1215

Kansas Department of Health and Environment-Division of Environment
(Water well Contractors)
Topeka, Kansas 66620

1. Location of well:	County	Fraction	Section number	Township number	Range number
	Sedgwick	1/4 SE 1/4 SE 1/4	19	T 28 S	R 2W E/W

2. Distance and direction from nearest town or city:
¼ West of 199th West on 55th South on
Street address of well location if in city: North side of Road.

3. Owner of well: John Wells
R.R. or street: RR 1
City, state, zip code: Viola, Kansas

4. Locate with "X" in section below:

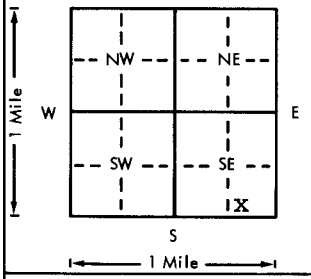

Sketch map:
Viola, Kansas

6. Bore hole dia. 11 in. Completion date
Well depth 40 ft. 5-6-77

7. __ Cable tool X Rotary __ Driven __ Dug
__ Hollow rod __ Jetted __ Bored __ Reverse rotary

8. Use: __ Domestic __ Public supply __ Industry
__ Irrigation __ Air conditioning X Stock
__ Lawn __ Oil field water __ Other

9. Casing: Material Styrene Height: Above or ~~below~~
Threaded __ Welded gl Surface 12 in.
RMP X PVC __ Weight __ lbs./ft.
Dia. 5 in. to 40 ft. depth Wall Thickness: inches or
Dia. __ in. to __ ft. depth gage No. .200

5. Type and color of material	From	To
Topsoil	0	3
Brown Clay	3	11
Fine Sand	11	25
Medium Sand	25	38
Blue Shale	38	40
(Use a second sheet if needed)		

10. Screen: Manufacturer's name Sunflower Plastic
Type Styrene Dia. 5"
Slot/~~gauze~~ .06 Length 10'
Set between 30 ft. and 40 ft.
ft. and ft.
Gravel pack? yes Size range of material ¼-1/8"

11. Static water level: mo./day/yr.
15 ft. below land surface Date 5-6-77

12. Pumping level below land surfaces:
ft. after hrs. pumping g.p.m.
ft. after hrs. pumping g.p.m.
Estimated maximum yield g.p.m.

13. Water sample submitted: mo./day/yr.
__ Yes __ No Date

14. Well head completion: Capped
__ Pitless adapter 12 Inches above grade

15. Well grouted? yes 1to2 fine sand mix.
With: __ Neat cement __ Bentonite X Concrete
Depth: From 40" ft. to 14 ft.

16. Nearest source of possible contamination: Septic
ft. 50 Direction South Type Tank
Well disinfected upon completion? X Yes __ No

17. Pump: X Not installed
Manufacturer's name
Model number HP Volts
Length of drop pipe ft. capacity g.p.m.
Type:
__ Submersible __ Turbine
__ Jet __ Reciprocating
__ Centrifugal __ Other

18. Elevation:

Topography:
__ Hill
__ Slope
__ Upland
__ Valley

19. Remarks:
Flat Ground

20. Water well contractor's certification:
This well was drilled under my jurisdiction and this report is true to the best of my knowledge and belief.
Harp Well & Pump 236
Business name License No.
Address Wichiata, Kansas
Signed M. Arnold Date 8-2-77
Authorized representative

T 28 R 2W Sec 19 1/4 1/4 1/4 SE

Forward the white, blue and pink copies to the Department of Health and Environment

Form WWC-5

MI-1023