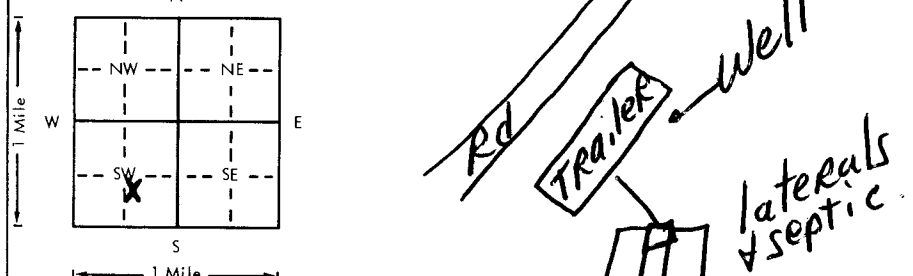


USE TYPEWRITER OR BALL
POINT PEN-PRESS FIRMLY,
PRINT CLEARLY.

WATER WELL RECORD
KSA 82a-1201-1215

Kansas Department of Health and
Environment-Division of Environment
(Water well Contractors)
Topeka, Kansas 66620

1. Location of well:		County: <u>Ledgewick</u>	Fraction: <u>NW 1/4 SE 1/4 SW 1/4</u>	Section number: <u>22</u>	Township number: <u>T 28 S R 2 E</u>	Range number: <u>2</u>
2. Distance and direction from nearest town or city:		3. Owner of well: <u>Wm Perry (CEN So.)</u>		R.R. or street: <u>16421 W. 54th South</u>		
Street address of well location if in city: <u>16421 W. 54th South</u>		City, state, zip code: <u>Wichita KS 67226</u>				
4. Locate with "X" in section below:		Sketch map:		6. Bore hole dia. <u>11</u> in. Completion date <u>4/17/79</u> Well depth <u>50</u> ft.		
				7. ☒ Cable tool ☒ Rotary ☐ Driven ☐ Dug ☐ Hollow rod ☐ Jetted ☐ Bored ☐ Reverse rotary		
5. Type and color of material		From		To		8. Use: ☒ Domestic ☐ Public supply ☐ Industry ☐ Irrigation ☐ Air conditioning ☐ Stock ☐ Lawn ☐ Oil field water ☐ Other
<u>Top soil</u>		<u>0</u>		<u>2</u>		9. Casing: Material <u>Steel</u> Weight: Above or below Threaded ☐ Welded ☒ Surface <u>1.35</u> in. RMP ☒ PVC ☐ Weight <u>1.35</u> lbs./ft. Dia. <u>5</u> in. to <u>52</u> ft. depth Wall Thickness: inches or Dia. <u>5</u> in. to <u>52</u> ft. depth gage No. <u>200</u>
<u>red clay</u>		<u>2</u>		<u>14</u>		10. Screen: Manufacturer's name <u>Sunflower</u> Type <u>200</u> Dia. <u>5 in</u> Slot/gauze <u>1/16</u> Length <u>96</u> ft. Set between <u>40</u> ft. and <u>96</u> ft. Gravel pack <u>yes</u> Size range of material <u>3/8</u>
<u>fine to med. sand</u>		<u>14</u>		<u>37</u>		11. Static water level: <u>15</u> ft. below land surface Date <u>4/17/79</u>
<u>charcoal shale</u>		<u>37</u>		<u>50</u>		12. Pumping level below land surfaces: <u>22</u> ft. after <u>1/2</u> hrs. pumping <u>10</u> g.p.m. ____ ft. after ____ hrs. pumping ____ g.p.m. Estimated maximum yield <u>12-18</u> g.p.m.
						13. Water sample submitted: ____ mo./day/yr. Yes ☒ No ☐ Date ____
						14. Well head completion: <u>12</u> inches above grade ____ Pitless adapter
						15. Well grouted? <u>yes</u> With: <u>Neat cement</u> ☐ Bentonite ☒ Concrete Depth: From <u>30</u> ft. to <u>12</u> ft.
						16. Nearest source of possible contamination: <u>Septic</u> ft. <u>70</u> Direction <u>SE</u> Type <u>Septic</u> Well disinfected upon completion? ☒ Yes ☐ No
						17. Pump: ☒ Not installed Manufacturer's name ____ Model number ____ HP ____ Volts ____ Length of drop pipe ____ ft. capacity ____ g.p.m. Type: ____ Submersible ____ Turbine ____ Jet ____ Reciprocating ____ Centrifugal ____ Other
18. Elevation:		19. Remarks:		20. Water well contractor's certification:		
Topography: ☒ Hill ☐ Slope ☐ Upland ☐ Valley		<u>Customer to furnish 4'x4'x4" slab around well at grade</u> <u>Per State Regulations</u> <u>Signed X Amelia Ben</u>		This well was drilled under my jurisdiction and this report is true to the best of my knowledge and belief. <u>Wm Perry</u> <u>3/18</u> Business name <u>Wichita</u> License No. ____ Address <u>Wichita</u> Signed <u>Amelia Ben</u> Date <u>4/17/79</u> Authorized representative		

Forward the white, blue and pink copies to the Department of Health and Environment

Form WWC-5