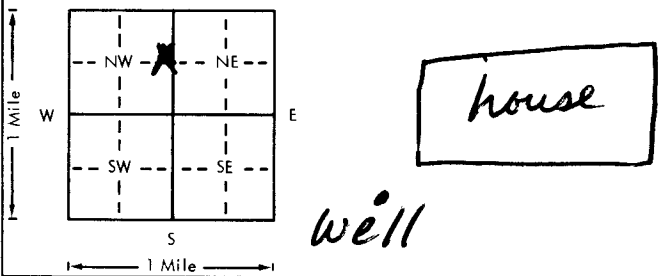


USE TYPEWRITER OR BALL
POINT PEN-PRESS FIRMLY,
PRINT CLEARLY.

WATER WELL RECORD
KSA 82a-1201-1215

Kansas Department of Health and
Environment-Division of Environment
(Water well Contractors)
Topeka, Kansas 66620

1. Location of well: County <u>Sedgwick</u> Fraction <u>SE 1/4 NE 1/4 NW 1/4</u> Section number <u>23</u> Township number <u>T 28 S</u> Range number <u>R 2 W</u>																									
2. Distance and direction from nearest town or city: <u>2 W 156 Schulte KS</u> Street address of well location if in city: <u>9435 W Central</u> City, state, zip code: <u>Wichita, KS 67212</u>																									
3. Owner of well: <u>Brian Proger</u>																									
4. Locate with "X" in section below: Sketch map: 																									
5. Type and color of material																									
<table border="1"><thead><tr><th></th><th>From</th><th>To</th></tr></thead><tbody><tr><td>Top Soil</td><td>0</td><td>12</td></tr><tr><td>fine sand</td><td>12</td><td>24</td></tr><tr><td>red clay</td><td>24</td><td>31</td></tr><tr><td>fine sand</td><td>31</td><td>58</td></tr><tr><td>red clay</td><td>58</td><td>62</td></tr><tr><td>fine to med sand</td><td>62</td><td>72</td></tr><tr><td>charcoal shale</td><td>72</td><td>81</td></tr></tbody></table>			From	To	Top Soil	0	12	fine sand	12	24	red clay	24	31	fine sand	31	58	red clay	58	62	fine to med sand	62	72	charcoal shale	72	81
	From	To																							
Top Soil	0	12																							
fine sand	12	24																							
red clay	24	31																							
fine sand	31	58																							
red clay	58	62																							
fine to med sand	62	72																							
charcoal shale	72	81																							
6. Bore hole dia. <u>8 1/2</u> in. Completion date: <u>6/18/80</u> Well depth <u>81</u> ft.																									
7. ☒ Cable tool ☒ Rotary ☐ Driven ☐ Dug ☐ Hollow rod ☐ Jetted ☐ Bored ☐ Reverse rotary																									
8. Use: ☒ Domestic ☐ Public supply ☐ Industry ☐ Irrigation ☐ Air conditioning ☐ Stock ☐ Lawn ☐ Oil field water ☐ Other																									
9. Casing: Material <u>Steel</u> Height: <u>0</u> Above or below Threaded ☐ Welded ☒ Surface <u>1 1/2</u> in. CMP ☒ PVC ☐ Weight <u>1.50</u> lbs./ft. Dia. <u>5</u> in. to <u>8 1/2</u> ft. depth Wall Thickness: inches or Dia. <u>5</u> in. to <u>8 1/2</u> ft. depth gage No. <u>200</u>																									
10. Screen: Manufacturer's name <u>Per Mac</u> Type <u>200</u> Dia. <u>5 in</u> Slot gauge <u>1/16</u> Length <u>6 ft</u> Set between <u>8 1/2</u> ft. and <u>8 1/2</u> ft. Gravel pack? <u>Yes</u> Size range of material <u>3/8</u>																									
11. Static water level: <u>20</u> ft. below land surface Date <u>6/18/80</u>																									
12. Pumping level below land surfaces: <u>60</u> ft. after <u>1/2</u> hrs. pumping <u>10</u> g.p.m. <u>60</u> ft. after <u>1/2</u> hrs. pumping <u>10</u> g.p.m. Estimated maximum yield <u>15</u> g.p.m.																									
13. Water sample submitted: <u>Yes</u> ☒ No ☐ Date <u>6/18/80</u>																									
14. Well head completion: <u>12</u> inches above grade																									
15. Well grouted? <u>Yes</u> With: <u>Neat cement</u> ☒ Bentonite ☒ Concrete ☐ Depth: From <u>30</u> ft. to <u>13</u> ft.																									
16. Nearest source of possible contamination: <u>150</u> ft. Direction <u>East</u> Type <u>Lagune</u> Well disinfected upon completion? ☒ Yes ☐ No																									
17. Pump: ☒ Not installed Manufacturer's name <u>Wenger</u> Model number <u>318</u> HP <u>3/8</u> Volts <u>115</u> Length of drop pipe <u>318</u> ft. capacity <u>3/8</u> g.p.m. Type: ☐ Submersible ☐ Turbine ☐ Jet ☐ Reciprocating ☐ Centrifugal ☐ Other																									
18. Elevation: Topography: ☒ Hill ☐ Slope ☐ Upland ☐ Valley																									
19. Remarks: (Use a second sheet if needed)																									
20. Water well contractor's certification: This well was drilled under my jurisdiction and this report is true to the best of my knowledge and belief. Business name <u>Wenger Bathy</u> License No. <u>318</u> Address <u>Sedgwick</u> Signature <u>Wenger</u> Date <u>6/18/80</u> Authorized representative																									

Forward the white, blue and pink copies to the Department of Health and Environment

Form WWC-5