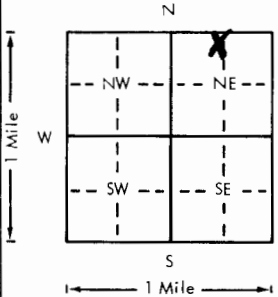
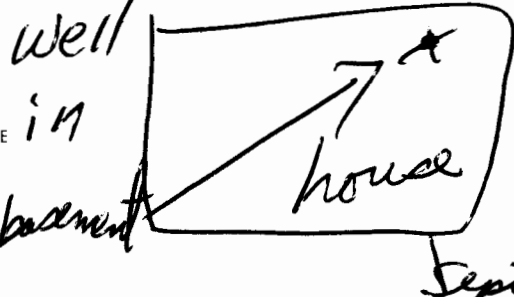


USE TYPEWRITER OR BALL
POINT PEN-PRESS FIRMLY,
PRINT CLEARLY.

WATER WELL RECORD
KSA 82a-1201-1215

Kansas Department of Health and
Environment-Division of Environment
(Water well Contractors)
Topeka, Kansas 66620

1. Location of well:		County: <u>Sedgwick</u>	Fraction: <u>NE 1/4 NW 1/4 NE 1/4</u>	Section number: <u>26</u>	Township number: <u>T 28 S</u>	Range number: <u>R 2 W</u>
2. Distance and direction from nearest town or city: Street address of well location if in city:		<u>6 miles N.W. Clearwater KS</u>		3. Owner of well: <u>Gary Thome</u> R.R. or street: <u>Rt 8</u> City, state, zip code: <u>Wichita KS 67215</u>		
4. Locate with "X" in section below:		Sketch map:		6. Bore hole dia. <u>11</u> in. Completion date: <u>3/16/79</u> Well depth: <u>60</u> ft.		
				7. ☒ Cable tool ☒ Rotary ☐ Driven ☐ Dug ☐ Hollow rod ☐ Jetted ☐ Bored ☐ Reverse rotary		
5. Type and color of material		From		To		8. Use: ☒ Domestic ☐ Public supply ☐ Industry ☐ Irrigation ☐ Air conditioning ☐ Stock ☐ Lawn ☐ Oil field water ☐ Other
<u>Top soil</u>		<u>0</u>		<u>2</u>		9. Casing: Material <u>Steel</u> Weight <u>0</u> Above or below Threaded ☒ Welded ☒ Surface <u>12</u> in. RMP ☒ PVC ☐ Weight <u>1.50</u> lbs./ft. Dia. <u>5</u> in. to <u>60</u> ft. depth Wall Thickness: inches or Dia. <u>5</u> in. to <u>60</u> ft. depth gage No. <u>200</u>
<u>red clay</u>		<u>2</u>		<u>12</u>		10. Screen: Manufacturer's name <u>Sunflower</u> Type <u>200</u> Dia. <u>5 in</u> Slot/gauze <u>1/16</u> Length <u>40 ft</u> Set between <u>20</u> ft. and <u>60</u> ft. <u>30</u> ft. and <u>60</u> ft.
<u>fine sand</u>		<u>12</u>		<u>15</u>		Gravel pack ☒ Size range of material <u>3/8</u>
<u>blue-green shale</u>		<u>15</u>		<u>30</u>		11. Static water level: <u>20</u> ft. below land surface Date: <u>3/16/79</u>
<u>brown shale</u>		<u>30</u>		<u>32</u>		12. Pumping level below land surfaces: <u>25</u> ft. after <u>1/2</u> hrs. pumping <u>20-30</u> g.p.m. <u>25</u> ft. after <u>1/2</u> hrs. pumping <u>20-30</u> g.p.m. Estimated maximum yield <u>20-30</u> g.p.m.
<u>blue-green shale</u>		<u>32</u>		<u>51</u>		13. Water sample submitted: <u>X</u> Yes <u>X</u> No Date <u>3/16/79</u>
<u>brown shale</u>		<u>51</u>		<u>52</u>		14. Well head completion: <u>12</u> Pitless adapter <u>12</u> inches above grade
<u>charcoal shale</u>		<u>52</u>		<u>60</u>		15. Well grouted? <u>yes</u> With: <u>Neat cement</u> <u>X</u> Bentonite <u>X</u> Concrete Depth: From <u>6</u> ft. to <u>16</u> ft.
						16. Nearest source of possible contamination: ft. <u>100</u> Direction <u>W</u> Type <u>Septic</u> Well disinfected upon completion? <u>X</u> Yes <u> </u> No
						17. Pump: <u>X</u> Not installed Manufacturer's name <u> </u> Model number <u> </u> HP <u> </u> Volts <u> </u> Length of drop pipe <u> </u> ft. capacity <u> </u> g.p.m. Type: <u> </u> Submersible <u> </u> Turbine <u> </u> Jet <u> </u> Reciprocating <u> </u> Centrifugal <u> </u> Other
18. Elevation:		19. Remarks:		20. Water well contractor's certification: This well was drilled under my jurisdiction and this report is true to the best of my knowledge and belief. <u>W. W. W. Drilling</u> Business name <u>318</u> License No. <u> </u> Address <u>Copwich KS</u> Signed <u>J. W. W.</u> Date <u>3/16/79</u> Authorized representative		

Forward the white, blue and pink copies to the Department of Health and Environment

Form WWC-5