


1 LOCATION OF WATER WELL: County: Kiowa Fraction: SW 1/4 SE 1/4 SE 1/4 Section Number: 3 Township Number: T 28 S Range Number: R 20 EW

Distance and direction from nearest town or city street address of well if located within city?
3 N. - 3/4 W. Mullinville Kansas

2 WATER WELL OWNER: Max Dean Liggett
 RR#, St. Address, Box # :
 City, State, ZIP Code : Mullinville Kans.
 Board of Agriculture, Division of Water Resources
 Application Number:

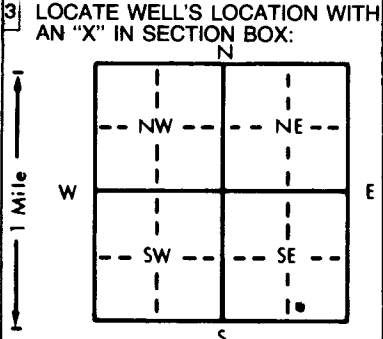

4 DEPTH OF COMPLETED WELL: 100 ft. ELEVATION:
 Depth(s) Groundwater Encountered 1. 70 ft. 2. ft. 3. ft.
 WELL'S STATIC WATER LEVEL: 70 ft. below land surface measured on mo/day/yr 6-26-84
 Pump test data: Well water was 70 ft. after 1 hours pumping 8 gpm
 Est. Yield 25 gpm: Well water was 70 ft. after 1 hours pumping 8 gpm
 Bore Hole Diameter: 8 3/4 in. to 100 ft., and 100 in. to 100 ft.
 WELL WATER TO BE USED AS:
 1 Domestic 3 Feedlot 6 Oil field water supply 9 Dewatering 12 Other (Specify below)
 2 Irrigation 4 Industrial 7 Lawn and garden only 10 Observation well
 Was a chemical/bacteriological sample submitted to Department? Yes No No X; If yes, mo/day/yr sample was submitted
 Water Well Disinfected? Yes X No

5 TYPE OF BLANK CASING USED:
 1 Steel 3 RMP (SR) 5 Wrought iron 8 Concrete tile CASING JOINTS: Glued X Clamped
 2 PVC 4 ABS 6 Asbestos-Cement 9 Other (specify below) Welded
 7 Fiberglass Threaded
 Blank casing diameter 5 in. to 80 ft., Dia 5 in. to 80 ft., Dia 5 in. to 80 ft.
 Casing height above land surface 24 in., weight 50R-26 lbs./ft. Wall thickness or gauge No. 50R-26
 TYPE OF SCREEN OR PERFORATION MATERIAL:
 1 Steel 3 Stainless steel 5 Fiberglass 8 RMP (SR) 10 Asbestos-cement
 2 Brass 4 Galvanized steel 6 Concrete tile 9 ABS 11 Other (specify)
 12 None used (open hole)
 SCREEN OR PERFORATION OPENINGS ARE:
 1 Continuous slot 3 Mill slot 5 Gauzed wrapped 8 Saw cut 11 None (open hole)
 2 Louvered shutter 4 Key punched 6 Wire wrapped 9 Drilled holes
 7 Torch cut 10 Other (specify)
 SCREEN-PERFORATED INTERVALS: From 80 ft. to 100 ft., From 80 ft. to 100 ft., From 80 ft. to 100 ft.
 GRAVEL PACK INTERVALS: From 65 ft. to 100 ft., From 65 ft. to 100 ft., From 65 ft. to 100 ft.

6 GROUT MATERIAL: 1 Neat cement 2 Cement grout 3 Bentonite 4 Other
 Grout intervals: From 0 ft. to 100 ft., From 0 ft. to 100 ft., From 0 ft. to 100 ft.
 What is the nearest source of possible contamination:
 1 Septic tank 4 Lateral lines 7 Pit privy 10 Livestock pens 14 Abandoned water well
 2 Sewer lines 5 Cess pool 8 Sewage lagoon 11 Fuel storage 15 Oil well/Gas well
 3 Watertight sewer lines 6 Seepage pit 9 Feedyard 12 Fertilizer storage 16 Other (specify below)
PASTURE
 Direction from well? All Around How many feet?

FROM	TO	LITHOLOGIC LOG	FROM	TO	LITHOLOGIC LOG
0	2	Top Soil			
2	8	Grady Clay			
8	62	Sandy Clay			
62	100	Gravel			

7 CONTRACTOR'S OR LANDOWNER'S CERTIFICATION: This water well was 1 constructed, (2) reconstructed, or (3) plugged under my jurisdiction and was completed on (mo/day/year) 6-21-84 and this record is true to the best of my knowledge and belief. Kansas Water Well Contractor's License No. 224 This Water Well Record was completed on (mo/day/yr) 7-3-85 under the business name of Carl Hays Water Well Serv by (signature) Carl Hays

INSTRUCTIONS: Use typewriter or ball point pen, PLEASE PRESS FIRMLY and PRINT clearly. Please fill in blanks, underline or circle the correct answers. Send top three copies to Kansas Department of Health and Environment, Division of Environment, Environmental Geology Section, Topeka, KS 66620. Send one to WATER WELL OWNER and retain one for your records.

OFFICE USE ONLY
T
R
EW
SEC.
1/4
1/4
1/4