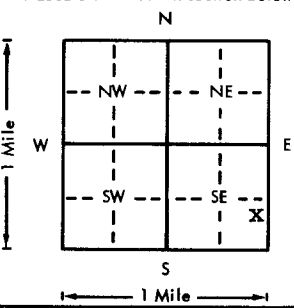


USE TYPEWRITER OR BALL POINT PEN—PRESS FIRMLY, PRINT CLEARLY.

WATER WELL RECORD  
KSA 82a-1201-1215

Kansas Department of Health and Environment—Division of Environment  
(Water well Contractors)  
Topeka, Kansas 66620

1. Location of well:	County <b>Kiowa</b>	Fraction <b>1/4 SE 1/4 SE 1/4</b>	Section number <b>6</b>	Township number <b>T 28 S R 20 E/W</b>	Range number <b>20</b>
2. Distance and direction from nearest town or city: <b>5 1/2 mi. Northwest of Mullenville, KS</b> Street address of well location if in city:			3. Owner of well: <b>Wayne Breusing</b> R.R. or street: <b>(?)</b> City, state, zip code: <b>Mullenville, KS 67109</b>		
4. Locate with "X" in section below: Sketch map: 			6. Bore hole dia. <b>24</b> in. Completion date <b>5-3-76</b> Well depth <b>90</b> ft.		
5. Type and color of material			7. <input type="checkbox"/> Cable tool <input type="checkbox"/> Rotary <input type="checkbox"/> Driven <input type="checkbox"/> Dug <input type="checkbox"/> Hollow rod <input type="checkbox"/> Jetted <input type="checkbox"/> Bored <input checked="" type="checkbox"/> Reverse rotary		
8. Use: <input type="checkbox"/> Domestic <input type="checkbox"/> Public supply <input type="checkbox"/> Industry <input checked="" type="checkbox"/> Irrigation <input type="checkbox"/> Air conditioning <input type="checkbox"/> Stack <input type="checkbox"/> Lawn <input type="checkbox"/> Oil field water <input type="checkbox"/> Other			9. Casing: Material <b>Steel</b> Height <b>Above</b> or below Threaded <input type="checkbox"/> Welded <input checked="" type="checkbox"/> Surface <b>12</b> in. RMP <input type="checkbox"/> PVC <input type="checkbox"/> Weight <b>30.3</b> lbs./ft. Dia. <b>16</b> in. to <b>50</b> ft. depth Wall Thickness: inches or Dia. <input type="checkbox"/> in. to <input type="checkbox"/> ft. depth gage No. <b>7 ga.</b>		
From To			10. Screen: Manufacturer's name <b>W. A. Brown</b>		
Top soil & sand			Type <b>Double-slot</b> Dia. <b>16"</b>		
Brown & gray clay & limestone			Slot/gauze <b>1/8</b> Length <b>40'</b>		
Sand, gravel & clay streaks at 42'-53' & at 82'			Set between <b>50</b> ft. and <b>90</b> ft. ft. and <input type="checkbox"/> ft.		
<del>XXXXXXXXXX</del>			Gravel pack? <b>Yes</b> Size range of material <b>3/8-200</b>		
			11. Static water level: <input type="checkbox"/> mo./day/yr. <b>38</b> ft. below land surface Date <b>4-9-76</b>		
			12. Pumping level below land surfaces: <b>N/C</b> <input type="checkbox"/> ft. after <input type="checkbox"/> hrs. pumping <input type="checkbox"/> g.p.m. <input type="checkbox"/> ft. after <input type="checkbox"/> hrs. pumping <input type="checkbox"/> g.p.m. Estimated maximum yield <input type="checkbox"/> g.p.m.		
			13. Water sample submitted: <input type="checkbox"/> mo./day/yr. <input type="checkbox"/> Yes <input checked="" type="checkbox"/> No Date <input type="checkbox"/>		
			14. Well head completion: <input type="checkbox"/> Pitless adapter <b>12</b> Inches above grade		
			15. Well grouted? <b>Yes</b> With: <input checked="" type="checkbox"/> Neat cement <input type="checkbox"/> Bentonite <input type="checkbox"/> Concrete Depth: From <b>0</b> ft. to <b>10</b> ft.		
			16. Nearest source of possible contamination: ft. <input type="checkbox"/> Direction <input type="checkbox"/> Type <input type="checkbox"/> Well disinfected upon completion? <input type="checkbox"/> Yes <input checked="" type="checkbox"/> No		
			17. Pump: Not installed Manufacturer's name <b>FMC Corp./Peerless</b> Model number <b>12MB-3</b> HP <b>50</b> Volts <input type="checkbox"/> Length of drop pipe <b>80</b> ft. capacity <b>900</b> g.p.m. Type: <input type="checkbox"/> Submersible <input checked="" type="checkbox"/> Turbine <input type="checkbox"/> Jet <input type="checkbox"/> Reciprocating <input type="checkbox"/> Centrifugal <input type="checkbox"/> Other		
(Use a second sheet if needed)					
18. Elevation:		19. Remarks:			
Topography: <input type="checkbox"/> Hill <input type="checkbox"/> Slope <input type="checkbox"/> Upland <input type="checkbox"/> Valley					
		20. Water well contractor's certification: This well was drilled under my jurisdiction and this report is true to the best of my knowledge and belief. <b>Clarke Well &amp; Eq., Inc.</b> <b>185</b> Business name License No. Address <b>Great Bend, KS</b> Signed <b>P. W. Clark</b> Date <b>5-18-76</b> Authorized representative			

28  
 20  
 6  
 SESE  
 1/4 1/4 76 1/4

Forward the white, blue and pink copies to the Department of Health and Environment

Form WWC-5