USE TYPEWRITER OR BALL POINT PEN-PRESS FIRMLY, PRINT CLEARLY.

T R EW sec 1/4 1/4 1/4 No.

WATER WELL RECORD
KSA 82a-1201-1215

Kansas State Dept. Of Health
(Water Well Contractors)
Forbes-Bldg. 740
Topeka, Kansas 66620

1 Location of well:	County	Township name	Fraction	Section number	Town number	Range number
	Kiowa	Martin	NE ~~XX~~ of NE	6	T28S	R20W

Distance and direction from nearest town or city: 7 mi. Northwest of Mullenville, KS

Street address of well location if in city:

3 Owner of well: Don Broomfield

Address: Augusta, KaNsas

Locate with "X" in section below:

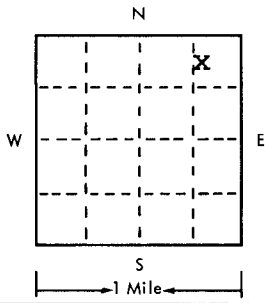

Sketch map:

4 Well depth: 62 ft. Date of completion 5-23-75
Well diameter 24 in.

5 ☐ Cable tool ☐ Rotary ☐ Driven ☐ Dug
☐ Hollow rod ☐ Jetted ☐ Bored ☒ Reverse rotary

6 Use: ☐ Domestic ☐ Public supply ☐ Industry
☒ Irrigation ☐ Air conditioning ☐ Commercial
☐ Test well ☐

7 Casing: Material Steel Height: (above) below
Threaded ☐ Welded ☒ Surface 12 in.
Diam. Weight 30.3 lbs./ft.
16 in. to 40 ft. depth Drive shoe? ☐ Yes ☒ No
16 in. to 62 ft. depth

2

Type and color of material	From	To
Top soil	0	2
Sandy gray clay	2	14
Sand, gravel & clay streaks	14	25
Sand & gravel	25	59
Brown clay	59	62
(use a second sheet if needed)		

8 Screen:
Manufacturer Johnson Division
Type .125 Irr. Dia. 16"
(Slot) gauze 1/8 Length 20'
Set between 40 ft. and 60 ft.
Fittings:
Gravel pack ☒ Yes ☐ No Size range of material 3/8-200

9 Static water level:
33 ft. below land surface Date 5-23-75

10 Pumping level below land surfaces: N/C
ft. after hrs. pumping g.p.m.
ft. after hrs. pumping g.p.m.
Estimated maximum yield g.p.m.

11 Water sample submitted:
☐ Yes ☒ No Date

12 Well head completion:
☐ Pitless adapter 12 Inches above grade

13 Well grouted? ☒ Yes ☐ No
☒ Neat cement ☐ Bentanite ☐
Depth: From 0 ft. to 10 ft.

14 Nearest source of possible contamination: NONE KNOWN
ft. Direction Type
Well disinfected upon completion? ☐ Yes ☒ No

15 Pump: ☒ Not installed
Manufacturer's name
Model number HP Volts
Length of drop pipe ft. capacity g.m.p.
Type:
☐ Submersible ☐ Turbine
☐ Jet ☐ Reciprocating
☐ Certrifugal ☐ Other

16 Remarks: elevation

Topography:
☐ Hill
☐ Slope
☐ Upland
☐ Valley

17 Water well contractor's certification:
This well was drilled under my jurisdiction and this report is true to the best of my knowledge and belief.
Clarke WEll & Eq., Inc. 185
Business name License No.
Address Great Bend, KS
Signed R. W. Clarke Date 5-23-75
Authorized representative

Forward the white, blue and pink copies to the Kansas State Dept. Of Health.

Form WWC-5

677-H