


1 LOCATION OF WATER WELL: County: IOWA Fraction: NE 1/4 SW 1/4 SW 1/4 Section Number: 9 Township Number: T 28 S Range Number: R 20 EW

Distance and direction from nearest town or city street address of well if located within city? From Mullinville 1/2 N 2 1/2 W 1/2 N 1/4 E

2 WATER WELL OWNER: MIKE TONER RR#, St. Address, Box #: MULLINVILLE, KS Board of Agriculture, Division of Water Resources Application Number:

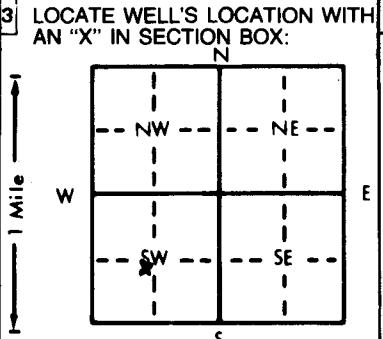

3 LOCATE WELL'S LOCATION WITH AN 'X' IN SECTION BOX: 4 DEPTH OF COMPLETED WELL: 85 ft. ELEVATION: ... ft. Depth(s) Groundwater Encountered: 1 60 ft. 2: ... ft. 3: ... ft. WELL'S STATIC WATER LEVEL: 59 ft. below land surface measured on mo/day/yr Pump test data: Well water was ... ft. after ... hours pumping ... gpm Est. Yield: 50 gpm; Well water was ... ft. after ... hours pumping ... gpm Bore Hole Diameter: 10 in. to 85 ft., and ... in. to ... ft. WELL WATER TO BE USED AS: 5 Public water supply 8 Air conditioning 11 Injection well 1 Domestic 3 Feedlot 6 Oil field water supply 9 Dewatering 12 Other (Specify below) 2 Irrigation 4 Industrial 7 Lawn and garden only 10 Monitoring well Was a chemical/bacteriological sample submitted to Department? Yes ... No ; If yes, mo/day/yr sample was submitted Water Well Disinfected? Yes ... No

5 TYPE OF BLANK CASING USED: 1 Steel 3 RMP (SR) 6 Asbestos-Cement 9 Other (specify below) 2 PVC 2 4 ABS 7 Fiberglass CASING JOINTS: Glued Clamped ... Welded ... Threaded ... Blank casing diameter: 5 in. to 24 60 ft., Dia ... in. to ... ft., Dia ... in. to ... ft. Casing height above land surface: 24 in., weight: 2.37 lbs./ft. Wall thickness or gauge No. 214 TYPE OF SCREEN OR PERFORATION MATERIAL: 1 Steel 3 Stainless steel 5 Fiberglass 8 RMP (SR) 11 Other (specify) 2 Brass 4 Galvanized steel 6 Concrete tile 9 ABS 12 None used (open hole) SCREEN OR PERFORATION OPENINGS ARE: 1 Continuous slot 3 Mill slot 5 Gauzed wrapped 8 Saw cut 11 None (open hole) 2 Louvered shutter 4 Key punched 6 Wire wrapped 9 Drilled holes 7 Torch cut 10 Other (specify) SCREEN-PERFORATED INTERVALS: From 60 ft. to 85 ft., From ... ft. to ... ft. GRAVEL PACK INTERVALS: From 20 ft. to 85 ft., From ... ft. to ... ft.

6 GROUT MATERIAL: 1 Neat cement 2 ~~Cement grout~~ 3 Bentonite 4 Other ... Grout Intervals: From 0 ft. to 20 ft., From ... ft. to ... ft., From ... ft. to ... ft. What is the nearest source of possible contamination: 1 Septic tank 4 Lateral lines 7 Pit privy 11 Fuel storage 15 Oil well/Gas well 2 Sewer lines 5 Cess pool 8 Sewage lagoon 12 Fertilizer storage 16 Other (specify below) 3 Watertight sewer lines 6 Seepage pit 9 Feedyard 13 Insecticide storage Direction from well? WEST How many feet? 100'

FROM	TO	LITHOLOGIC LOG	FROM	TO	PLUGGING INTERVALS
<u>0</u>	<u>60</u>	<u>SAND</u>			
<u>60</u>	<u>85</u>	<u>SAND GRAVEL</u>			
<u>84</u>	<u>85</u>	<u>WHITE CLAY</u>			

7 CONTRACTOR'S OR LANDOWNER'S CERTIFICATION: This water well was (1) constructed, (2) reconstructed, or (3) plugged under my jurisdiction and was completed on (mo/day/year) 1-8-90 and this record is true to the best of my knowledge and belief. Kansas Water Well Contractor's License No. 411 This Water Well Record was completed on (mo/day/yr) 1-23-90 under the business name of LEAH WATER WELL by (signature) Ron Lehl