


1 LOCATION OF WATER WELL: County: kiowa Fraction: SE 1/4 SE 1/4 NE 1/4 Section Number: 10 Township Number: T 28 S Range Number: R 20 E

Distance and direction from nearest town or city street address of well if located within city?
From Mullinville, three miles north, half west, & quarter mile north.

2 WATER WELL OWNER: Greg Price
 RR#, St. Address, Box #: Rt. 1 Box 204
 City, State, ZIP Code: Mullinville, KS. 67109
 Board of Agriculture, Division of Water Resources
 Application Number:

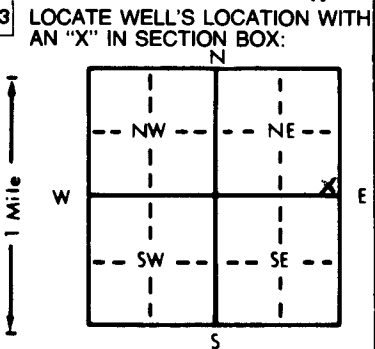

4 DEPTH OF COMPLETED WELL: 110' ft. ELEVATION: ft.
 Depth(s) Groundwater Encountered 1. ft. 2. ft. 3. ft.
 WELL'S STATIC WATER LEVEL: 62' ft. below land surface measured on mo/day/yr
 Pump test data: Well water was ft. after hours pumping gpm
 Est. Yield gpm: Well water was ft. after hours pumping gpm
 Bore Hole Diameter: 7 7/8" in. to ft., and in. to ft.
 WELL WATER TO BE USED AS:
 1 Domestic (circled) 3 Feedlot 6 Oil field water supply 9 Dewatering 12 Other (Specify below)
 2 Irrigation 4 Industrial 7 Lawn and garden only 10 Monitoring well
 Was a chemical/bacteriological sample submitted to Department? Yes.....No X.....; If yes, mo/day/yr sample was submitted
 Water Well Disinfected? Yes X No

5 TYPE OF BLANK CASING USED:
 1 Steel 3 RMP (SR) 5 Wrought iron 8 Concrete tile CASING JOINTS: Glued X Clamped
 2 PVC (circled) 4 ABS 6 Asbestos-Cement 9 Other (specify below) Welded
 Blank casing diameter: 5" in. to 90' ft., Dia. in. to ft., Dia. in. to ft.
 Casing height above land surface: 14" in., weight lbs./ft. Wall thickness or gauge No. SPR. 21
 TYPE OF SCREEN OR PERFORATION MATERIAL:
 1 Steel 3 Stainless steel 5 Fiberglass 8 RMP (SR) 10 Asbestos-cement
 2 Brass 4 Galvanized steel 6 Concrete tile 9 ABS 11 Other (specify)
 SCREEN OR PERFORATION OPENINGS ARE:
 1 Continuous slot 3 Mill slot 5 Gauzed wrapped 8 Saw cut (circled) 11 None (open hole)
 2 Louvered shutter 4 Key punched 6 Wire wrapped 9 Drilled holes
 7 Torch cut 10 Other (specify)
 SCREEN-PERFORATED INTERVALS: From 90' ft. to 110' ft., From ft. to ft.
 From ft. to ft., From ft. to ft.
 GRAVEL PACK INTERVALS: From 24' ft. to 75' ft., From ft. to ft.
 From 80' ft. to 110' ft., From ft. to ft.

6 GROUT MATERIAL: 1 Neat cement 2 Cement grout 3 Bentonite (circled) 4 Other
 Grout Intervals: From 20 ft. to 3 ft., From ft. to ft., From ft. to ft.
 What is the nearest source of possible contamination:
 1 Septic tank 4 Lateral lines 7 Pit privy 10 Livestock pens (circled) 14 Abandoned water well
 2 Sewer lines 5 Cess pool 8 Sewage lagoon 11 Fuel storage 15 Oil well/Gas well
 3 Watertight sewer lines 6 Seepage pit 9 Feedyard 12 Fertilizer storage 16 Other (specify below)
 13 Insecticide storage
 Direction from well? Northwest
 How many feet? 25'

FROM	TO	LITHOLOGIC LOG	FROM	TO	PLUGGING INTERVALS
0	2	Topsoil			
2	45	Brown clay + fine sand layers			
45	64	Med. Sand			
64	65	Brown clay			
65	71	Med. Sand			
71	80	Brown clay			
80	88	White clay			
88	102	Med. sand + white clay layers			
102	110	Med. sand + red clay			

7 CONTRACTOR'S OR LANDOWNER'S CERTIFICATION: This water well was (1) constructed, (2) reconstructed, or (3) plugged under my jurisdiction and was completed on (mo/day/year) 10-26-93 and this record is true to the best of my knowledge and belief. Kansas Water Well Contractor's License No. 533 This Water Well Record was completed on (mo/day/yr) 11-25-93 under the business name of Jantzen Water Well Repair by (signature) [Signature]

OFFICE USE ONLY
T
R
EW
SEC.
1/4
1/4
1/4