


1 LOCATION OF WATER WELL: County: ~~XOLAR~~ Kiowa **49** Fraction SW 1/4 SW 1/4 NE 1/4 Section Number 20 Township Number T 28 S Range Number R 20 **EW**

Distance and direction from nearest town or city street address of well if located within city?
From Mullinville - 2 Miles West, 1/2 Mile North & 1/4 Mile West.

2 WATER WELL OWNER: John Rose
RR#, St. Address, Box #: R R #1 - Box 126 Board of Agriculture, Division of Water Resources
City, State, ZIP Code: Mullinville, Kansas 67109 Application Number: 38645

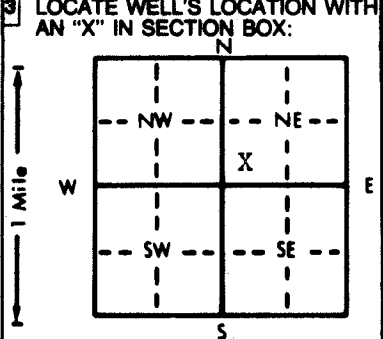

4 DEPTH OF COMPLETED WELL: 135 ft. ELEVATION:
 Depth(s) Groundwater Encountered 1. ft. 2. ft. 3. ft.
 WELL'S STATIC WATER LEVEL ... 51 ... ft. below land surface measured on mo/day/yr 3-10-88 ...
 Pump test data: Well water was ft. after hours pumping gpm
 Est. Yield gpm: Well water was ft. after hours pumping gpm
 Bore Hole Diameter ... 30 ... in. to ft., and in. to ft.
 WELL WATER TO BE USED AS: 5 Public water supply 8 Air conditioning 11 Injection well
 1 Domestic 3 Feedlot 6 Oil field water supply 9 Dewatering 12 Other (Specify below)
 ② Irrigation 4 Industrial 7 Lawn and garden only 10 Observation well
 Was a chemical/bacteriological sample submitted to Department? Yes No **X**; If yes, mo/day/yr sample was sub-
 mitted Water Well Disinfected? Yes No **X**

5 TYPE OF BLANK CASING USED: 5 Wrought iron 8 Concrete tile CASING JOINTS: Glued Clamped
 1 Steel 3 RMP (SR) 6 Asbestos-Cement 9 Other (specify below) Welded **X**
 2 PVC 4 ABS 7 Fiberglass Threaded
 Blank casing diameter ... 16 ... in. to 0' to 90' ft., Dia 130' to 135' in. to ft., Dia in. to ft.
 Casing height above land surface ... 20 ... in., weight 42.05 ... lbs./ft. Wall thickness or gauge No. ... 250 ...
 TYPE OF SCREEN OR PERFORATION MATERIAL: 7 PVC 10 Asbestos-cement
 ① Steel 3 Stainless steel 5 Fiberglass 8 RMP (SR) 11 Other (specify)
 2 Brass ④ Galvanized steel 6 Concrete tile 9 ABS 12 None used (open hole)
 SCREEN OR PERFORATION OPENINGS ARE: 5 Gauzed wrapped 6 Saw cut 11 None (open hole)
 1 Continuous slot ③ Mill slot ⑥ Wire wrapped 9 Drilled holes
 2 Louvered shutter 4 Key punched 7 Torch cut 10 Other (specify)
 SCREEN-PERFORATED INTERVALS: From ... 90 ... ft. to ... 130 ... ft., From ft. to ft.
 From ft. to ft., From ft. to ft.
 GRAVEL PACK INTERVALS: From ... 20 ... ft. to ... 135 ... ft., From ft. to ft.
 From ft. to ft., From ft. to ft.

6 GROUT MATERIAL: 1 Neat cement ② Cement grout 3 Bentonite 4 Other
 Grout Intervals: From ... 0 ... ft. to ... 20 ... ft., From ft. to ft., From ft. to ft.
 What is the nearest source of possible contamination: 10 Livestock pens 14 Abandoned water well
 1 Septic tank 4 Lateral lines 7 Pit privy 11 Fuel storage 15 Oil well/Gas well
 2 Sewer lines 5 Cess pool 8 Sewage lagoon 12 Fertilizer storage 16 Other (specify below)
 3 Watertight sewer lines 6 Seepage pit 9 Feedyard 13 Insecticide storage
 Direction from well? How many feet? **N/A**

| FROM | TO | LITHOLOGIC LOG | FROM | TO | LITHOLOGIC LOG |
|------|----|------------------|------|----|----------------|
| | | See attached log | | | |
| | | | | | |
| | | | | | |
| | | | | | |
| | | | | | |
| | | | | | |
| | | | | | |
| | | | | | |
| | | | | | |
| | | | | | |

7 CONTRACTOR'S OR LANDOWNER'S CERTIFICATION: This water well was ① constructed, (2) reconstructed, or (3) plugged under my jurisdiction and was completed on (mo/day/year) 3-23-88 and this record is true to the best of my knowledge and belief. Kansas Water Well Contractor's License No. 208 This Water Well Record was completed on (mo/day/yr) 4-6-88 under the business name of Minter-Wilson Drilling Co., Inc. by (signature) *Dona Keller*

INSTRUCTIONS: Use typewriter or ball point pen. PLEASE PRESS FIRMLY and PRINT clearly. Please fill in blanks, underline or circle the correct answers. Send top three copies to Kansas Department of Health and Environment, Bureau of Water Protection, Topeka, Kansas 66620-7320, Telephone: 913-862-9360. Send one to WATER WELL OWNER and retain one for your records.

OFFICE USE ONLY T 28 R 20 EW SEC. 20 SWN SWN NE

The
Professionals

MINTER-WILSON DRILLING CO.
INCORPORATED

and Domestic
Water Systems
Complete Installation
and Repairing

Phone 276-8269 • P.O. Box A • GARDEN CITY, KANSAS 67846

John Rose
Kiowa County
9-10-87

Location: NE $\frac{1}{4}$ 20-28-20
Mullinville on West 154 - 2 W., $\frac{1}{2}$ N. & $\frac{1}{2}$ W.
2/10ths W. & 2/10ths S. of pivot

Static Water Level - 50'

Test #4

| | | |
|-----|-----|---|
| 0 | 1 | Top soil $\phi 1$ |
| 1 | 4 | Fine sand $\phi 7$ |
| 4 | 20 | Brown clay $\phi 1$ |
| 20 | 47 | Fine to medium sand $\phi 5$ |
| 47 | 68 | Fine to medium sand & gravel - loose /7 |
| 68 | 75 | Brown clay - tight $\phi 1$ |
| 75 | 80 | Fine to medium sand & gravel - small yellow rock - loose |
| 80 | 127 | Fine to medium sand & gravel - coarse yellow /7 rock - loose |
| 127 | 133 | Yellow gray clay - tight $\phi 1$ |
| 133 | 140 | Blue shale - hard /9 |