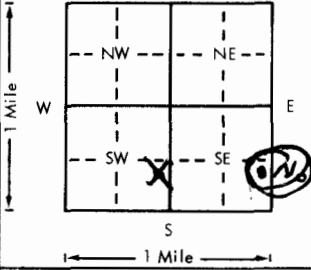


USE TYPEWRITER OR BALL POINT PEN-PRESS FIRMLY, PRINT CLEARLY.

WATER WELL RECORD
KSA 82a-1201-1215

Kansas Department of Health and Environment
Division of Environment
(Water well Contractors)
Topeka, Kansas 66620

1. Location of well: County kiowa Fraction NE¹/₄ SE¹/₄ SE¹/₄ Section number 35 Township number T 28 S R 20 Range number 20 NW	
2. Distance and direction from nearest town or city: 2 1/2 S Mullinville Kansas Street address of well location if in city: Kansas 3. Owner of well: Paul W. Hays Sr R.R. or street: Mullinville Kans City, state, zip code:	
4. Locate with "X" in section below: Sketch map: 	
5. Type and color of material	
	From To
TOP	0 2
Brown Clay	2 119
Gravel	119 138
Brown Clay	138 142
Shale	142 145
(Use a second sheet if needed)	
18. Elevation: Topography: <input type="checkbox"/> Hill <input type="checkbox"/> Slope <input checked="" type="checkbox"/> Upland <input type="checkbox"/> Valley	19. Remarks: I moved X on map because road is on 1/2 mile line Carl
6. Bore hole dia. 8 1/2 in. Completion date 6-2-79 Well depth 145 ft.	
7. Cable tool <input checked="" type="checkbox"/> Rotary <input type="checkbox"/> Driven <input type="checkbox"/> Dug <input type="checkbox"/> Hollow rod <input type="checkbox"/> Jetted <input type="checkbox"/> Bored <input type="checkbox"/> Reverse rotary	
8. Use: <input checked="" type="checkbox"/> Domestic <input type="checkbox"/> Public supply <input type="checkbox"/> Industry <input type="checkbox"/> Irrigation <input type="checkbox"/> Air conditioning <input type="checkbox"/> Stock <input type="checkbox"/> Lawn <input type="checkbox"/> Oil field water <input type="checkbox"/> Other	
9. Casing: Material _____ Height: Above or below Throded _____ Welded _____ Surface 12 in. RMP <input checked="" type="checkbox"/> PVC _____ Weight _____ lbs./ft. Dia. _____ in. to _____ ft. depth Wall Thickness: inches or Dia. _____ in. to _____ ft. depth gage No. 200	
10. Screen: Manufacturer's name Sunflower Plastics Type RMP Dia. 5" Slot gauze 1/8 Length 30 Set between 125 ft. and 145 ft. Gravel pack? <input checked="" type="checkbox"/> Size range of material 4x3/4	
11. Static water level: _____ mo./day/yr. 132 ft. below land surface Date 6-2-79	
12. Pumping level below land surfaces: 139 ft. after 1 hrs. pumping 7 g.p.m. _____ ft. after _____ hrs. pumping _____ g.p.m. Estimated maximum yield 7 g.p.m.	
13. Water sample submitted: _____ mo./day/yr. Yes <input type="checkbox"/> No <input checked="" type="checkbox"/> Date _____	
14. Well head completion: <input checked="" type="checkbox"/> Pitless adapter 12 inches above grade	
15. Well grouted? <input checked="" type="checkbox"/> With: <input checked="" type="checkbox"/> Neat cement <input type="checkbox"/> Bentonite <input type="checkbox"/> Concrete Depth: From 4 ft. to 14 ft.	
16. Nearest source of possible contamination: _____ ft. _____ Direction NE Type Septic Well disinfected upon completion? <input checked="" type="checkbox"/> Yes <input type="checkbox"/> No	
17. Pump: _____ Not installed Manufacturer's name F+W I Model number 18912 HP 3/4 Volts 230 Length of drop pipe 13 1/8 ft. capacity 10 g.p.m. Type: <input checked="" type="checkbox"/> Submersible <input type="checkbox"/> Turbine <input type="checkbox"/> Jet <input type="checkbox"/> Reciprocating <input type="checkbox"/> Centrifugal <input type="checkbox"/> Other	
20. Water well contractor's certification: This well was drilled under my jurisdiction and this report is true to the best of my knowledge and belief. Carl Hays Water Well Drw 224 Business name Carl Hays Water Well Drilling License No. 6852 Signed Carl Hays Date 6-2-79 Authorized representative	

T 28 R 20 S NW 35 NESESE 1/4 1/4 1/4

Forward the white, blue and pink copies to the Department of Health and Environment

Form WWC-5