

428


WATER WELL RECORD Form WWC-5 KSA 82a-1212

1 LOCATION OF WATER WELL: Fraction Section Number Township Number Range Number  
COUNTY: KIOWA SW 1/4 NE 1/4 SW 1/4 8 T 28 S R 20 W

Distance and direction from nearest town or city street address of well if located within city?  
1.5 NORTH, 3.5 WEST, .75 NORTH OF MULLINVILLE

2 WATER WELL OWNER: TONER, MIKE  
RR#, St. Address, Box #: RR Board of Agriculture, Division of Water Resources  
City, State, ZIP code: MULLINVILLE, KS 67109- Application Number:

3 LOCATE WELL'S LOCATION WITH AN "X" IN SECTION BOX:

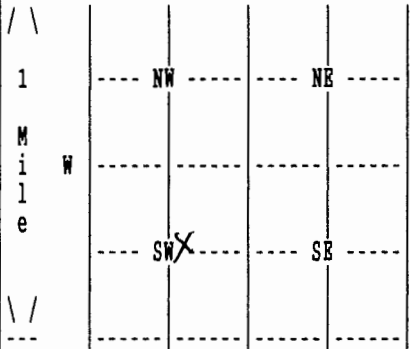

4 DEPTH OF COMPLETED WELL 92 ELEVATION: 0  
Depth(s) Groundwater Encountered 1. 0 ft. 2. 0 ft. 3. 0 ft.

WELL'S STATIC WATER LEVEL 62 ft. below land surface measured on mo/day/yr 04/02/15  
Pump test data: Well water was 0 ft. after 0 hours pumping 0 gpm

Estimated Yield 0 gpm: Well water was 0 ft. after 0 hours pumping 0 gpm

Bore Hole Diameter 8.75 in. to 92 ft., and in. to 0 ft.

WELL WATER TO BE USED AS: LIVESTOCK

Was a chemical/bacteriological sample submitted to department? No ;  
If yes, mo/day/yr sample was submitted Water well disinfected? Yes

5 TYPE OF BLANK CASING USED: PVC CASING JOINTS: GLUED  
Blank casing diameter 5 in. to 72 ft., Dia in. to 0 ft., Dia in. to 0 ft.  
Casing height above land surface 12 in., weight 0 lbs/ft. Wall thickness or gauge No. 26  
TYPE OF SCREEN OR PERFORATION MATERIAL: PVC  
SCREEN OR PERFORATION OPENINGS ARE: SAW CUT

SCREEN PERFORATED INTERVALS: From 72 ft. to 92 ft., From 0 ft. to 0 ft.  
From 0 ft. to 0 ft., From 0 ft. to 0 ft.  
GRAVEL PACK INTERVALS: From 24 ft. to 92 ft., From 0 ft. to 0 ft.  
From 0 ft. to 0 ft., From 0 ft. to 0 ft.

6 GROUT MATERIAL BENTONITE  
Grout Intervals: From 0 ft. to 24 ft., From 0 ft. to 0 ft., From 0 ft. to 0 ft.  
What is the nearest source of possible contamination: SEPTIC TANK  
Direction from well? WEST How many feet? 2800

FROM	TO	LITHOLOGIC LOG	FROM	TO	PLUGGING INTERVALS
0	17	TAN CLAY			
17	22	SAND			
22	38	TAN CLAY			
38	41	SAND AND GRAVEL			
41	53	TAN CLAY			
53	62	SAND AND GRAVEL			
62	68	TAN CLAY			
68	92	BROWN SANDSTONE			
92	93	RED CLAY			

7 CONTRACTOR'S OR LANDOWNER'S CERTIFICATION: This water well was Constructed under my jurisdiction and was completed on (mo/day/year) 04/02/15 and this record is true to the best of my knowledge and belief. Kansas Water Well Contractor's License No. 653 This Water Well Record was completed on (mo/day/yr) 04/25/15 under the business name of DAN HAYSE WATER WELL SERV by (signature)

*Don Hayse*