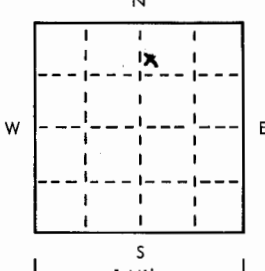
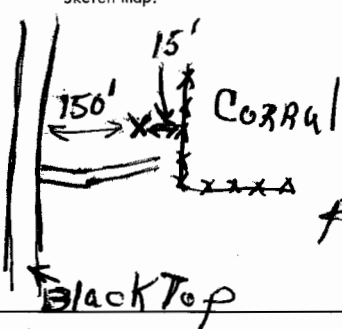


USE TYPEWRITER OR BALL
POINT PEN-PRESS FIRMLY,
PRINT CLEARLY.

WATER WELL RECORD
KSA 82a-1201-1215

T R EW sec 1/4 1/4 1/4 No.

Kansas State Dept. Of Health
(Water Well Contractors)
Forbes-Bldg. 740
Topeka, Kansas 66620

| | | | | | | |
|---|--------------------|---|--------------------------|---|---------------------------|----------------------------|
| 1 Location of well: | County <u>FORD</u> | Township name <u>Pleasant</u> | Fraction <u>SW-NW-NE</u> | Section number <u>5</u> | Town number <u>T-28-S</u> | Range number <u>R 21 W</u> |
| Distance and direction from nearest town or city: <u>Valley 5 1/2 N. of Bucklin</u> | | | | 3 Owner of well: <u>Mrs. Paul Neal</u> | | |
| Street address of well location if in city: <u>Kansas</u> | | | | Address: <u>Bucklin Kansas</u> | | |
| Locate with "X" in section below: | | Sketch map: | | 4 Well depth: <u>71</u> ft. Date of completion <u>1-30-76</u> | | |
|  | |  | | Well diameter <u>8 3/4</u> in. | | |
| 2 | | Type and color of material | | From | | To |
| TOP Soil | | | | 0 | | 2 |
| Sandy Clay | | | | 2 | | 26 |
| Gravel 1/4" to 1" | | | | 26 | | 42 |
| Clay | | | | 42 | | 48 |
| Gravel | | | | 48 | | 49 |
| Clay | | | | 49 | | 54 |
| Clay (Very Tight) | | | | 54 | | 56 |
| Clay Cream To White | | | | 56 | | 72 |
| Shale | | | | 72 | | 80 |
| 16 Remarks: elevation <u>Slope About 18" in 15' To the East. This will be just Adequate For Livestock. Water Table Has Dropped</u> | | | | | | |
| Topography: <input type="checkbox"/> Hill <input checked="" type="checkbox"/> Slope <input type="checkbox"/> Upland <input type="checkbox"/> Valley | | | | | | |
| 17 Water well contractor's certification: This well was drilled under my jurisdiction and this report is true to the best of my knowledge and belief. | | | | | | |
| Business name: <u>Carl Hays Water Well Service</u> License No. <u>603-50 Maple 224</u> | | | | | | |
| Address: <u>Carl Hays</u> Date: <u>1-30-76</u> | | | | | | |
| Signed: <u>Carl Hays</u> Authorized representative | | | | | | |