USE TYPEWRITER OR BALL POINT PEN-PRESS FIRMLY, PRINT CLEARLY.

T R EW sec 1/4 1/4 1/4 No.

WATER WELL RECORD
KSA 82a-1201-1215

Kansas State Dept. Of Health
(Water Well Contractors)
Forbes-Bldg. 740
Topeka, Kansas 66620

1 Location of well:	County	Township name	Fraction	Section number	Town number	Range number
	Ford	Valley	C SW1/4	9	T28S	R21W

Distance and direction from nearest town or city: 4 Mi. N, 3/4 E. of
Street address of well location if in city: Bucklin, Kansas

3 Owner of well: Leo Konda
Address: Spearville, Kansas

Locate with "X" in section below: Sketch map:

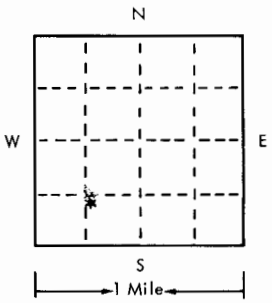

4 Well depth: 97 ft. Date of completion 3-3-75
Well diameter 28" in.

5 ☐ Cable tool ☐ Rotary ☐ Driven ☐ Dug
☐ Hollow rod ☐ Jetted ☐ Bored ☒ Reverse rotary

6 Use: ☐ Domestic ☐ Public supply ☐ Industry
☒ Irrigation ☐ Air conditioning ☐ Commercial
☐ Test well ☐ _____

7 Casing: Material steel Height: above/~~below~~
Threaded ☐ Welded ☒ Surface 12 in.
Diam. Weight 37 lbs./ft.
16 in. to 97 ft. depth Drive shoe? ☐ Yes ☒ No
___ in. to ___ ft. depth

2 Type and color of material	From	To
Top soil	0	10
sand & clay mixed	10	60
sand & gravel(water bearing)	60	97
Shale	97	

(use a second sheet if needed)

8 Screen:
Manufacturer W.A. Brown
Type punch slot Dia. 16"
Slot/gauze 3/16" Length 40'
Set between 57 ft. and 97 ft.
Fittings: 1/4x5/8"
Gravel pack ☒ Yes ☐ No Size range of material ___

9 Static water level:
40 ft. below land surface Date 3-3-75

10 Pumping level below land surfaces:
40 ft. after 2 hrs. pumping 1000 g.p.m.
___ ft. after ___ hrs. pumping ___ g.p.m.
Estimated maximum yield 1000 g.p.m.

11 Water sample submitted:
☐ Yes ☒ No Date _____

12 Well head completion:
☐ Pitless adapter ☒ Inches above grade 12"

13 Well grouted? ☒ Yes ☐ No
☐ Neat cement ☐ Bentonite ☐ clay mix
Depth: From 0 ft. to 10 ft.

14 Nearest source of possible contamination: none
ft. ___ Direction ___ Type ___
Well disinfected upon completion? ☐ Yes ☒ No

15 Pump: ☒ Not installed
Manufacturer's name Fairbanks Morse
Model number 7000 HP 75 Volts 460
Length of drop pipe 80 ft. capacity 1000 g.p.m.
Type:
☐ Submersible ☐ Turbine
☐ Jet ☐ Reciprocating
☐ Certrifugal ☐ Other

16 Remarks: elevation

Topography: Flat
☐ Hill
☐ Slope
☐ Upland
☐ Valley

17 Water well contractor's certification:
This well was drilled under my jurisdiction and this report is true to the best of my knowledge and belief.
Brau Drilling Co 217
Business name License No.
Address Bucklin, Kansas
Signed Roland Brau Date 3-3-75
Authorized representative

Forward the white, blue and pink copies to the Kansas State Dept. Of Health.

Form WWC-5