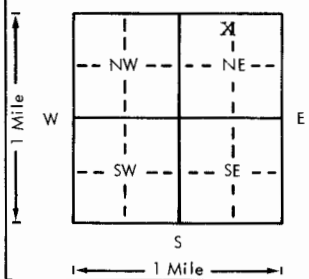


USE TYPEWRITER OR BALL
POINT PEN-PRESS FIRMLY,
PRINT CLEARLY.

WATER WELL RECORD
KSA 82a-1201-1215

Kansas Department of Health and
Environment-Division of Environment
(Water well Contractors)
Topeka, Kansas 66620

ABA

1. Location of well:		County Ford	Fraction ne 1/4 nw 1/4 ne 1/4	Section number 14	Township number T 28 S R 21 E/W	Range number
2. Distance and direction from nearest town or city: 2-N 2-E 2-N 3/4-E south side from Street address of well location if in city: Bucklin, Ks.				3. Owner of well: Slawson Drilling R.R. or street: Box 1131 City, state, zip code: Great Bend, Kansas 67530		
4. Locate with "X" in section below: N  W E S 1 Mile				Sketch map:		
5. Type and color of material				From	To	6. Bore hole dia. 10 in. Completion date _____ Well depth 110 ft. 2-27-79
sandy top soil				0	2	7. Cable tool <input checked="" type="checkbox"/> Rotary <input type="checkbox"/> Driven <input type="checkbox"/> Dug <input type="checkbox"/> Hollow rod <input type="checkbox"/> Jetted <input type="checkbox"/> Bored <input type="checkbox"/> Reverse rotary
fine sand & clay				2	49	8. Use: <input type="checkbox"/> Domestic <input type="checkbox"/> Public supply <input type="checkbox"/> Industry <input type="checkbox"/> Irrigation <input type="checkbox"/> Air conditioning <input type="checkbox"/> Stock <input type="checkbox"/> Lawn <input checked="" type="checkbox"/> Oil field water <input type="checkbox"/> Other
sand & gravel				49	111	9. Casing: Material PVC Height: Above or below _____ Threaded <input type="checkbox"/> Welded <input type="checkbox"/> Surface 24 in. RMP <input type="checkbox"/> PVC <input checked="" type="checkbox"/> Weight _____ lbs./ft. Dia. 5 1/2 in. to 110 ft. depth Wall Thickness: inches or Dia. _____ in. to _____ ft. depth gage No. 258
shale				111	113	10. Screen: Manufacturer's name CertainTeed Type pvc Dia. _____ Slot 1/16 Length 20 Set between 90 ft. and 110 ft. _____ ft. and _____ ft. Gravel pack? <input checked="" type="checkbox"/> Size range of material 3/4 3/8
Rock 111						11. Static water level: _____ mo./day/yr. 52 ft. below land surface Date 2-27-79
52						12. Pumping level below land surfaces: na _____ ft. after _____ hrs. pumping _____ g.p.m. _____ ft. after _____ hrs. pumping _____ g.p.m. Estimated maximum yield _____ g.p.m.
59' sat. level						13. Water sample submitted: _____ mo./day/yr. <input checked="" type="checkbox"/> Yes <input type="checkbox"/> No Date 2-27-79
						14. Well head completion: <input type="checkbox"/> Pitless adapter _____ Inches above grade
						15. Well grouted? <input checked="" type="checkbox"/> With: <input checked="" type="checkbox"/> Neat cement <input type="checkbox"/> Bentonite <input type="checkbox"/> Concrete Depth: From 0 ft. to 10 ft.
						16. Nearest source of possible contamination: ft. 250 Direction east Type oilwell Well disinfected upon completion? <input checked="" type="checkbox"/> Yes <input type="checkbox"/> No
						17. Pump: <input checked="" type="checkbox"/> Not installed Manufacturer's name _____ Model number _____ HP _____ Volts _____ Length of drop pipe _____ ft. capacity _____ g.p.m. Type: <input type="checkbox"/> Submersible <input type="checkbox"/> Turbine <input type="checkbox"/> Jet <input type="checkbox"/> Reciprocating <input type="checkbox"/> Centrifugal <input type="checkbox"/> Other
(Use a second sheet if needed)						
18. Elevation:		19. Remarks:				
Topography: <input type="checkbox"/> Hill <input type="checkbox"/> Slope <input checked="" type="checkbox"/> Upland <input type="checkbox"/> Valley		TOPO 2855 111 114				
20. Water well contractor's certification: This well was drilled under my jurisdiction and this report is true to the best of my knowledge and belief. Rosencrantz-Bemis 134 Business name License No. Address Great Bend, Kansas 67530 Signed Sandy K. Tope Date 3-27-79 Authorized representative						