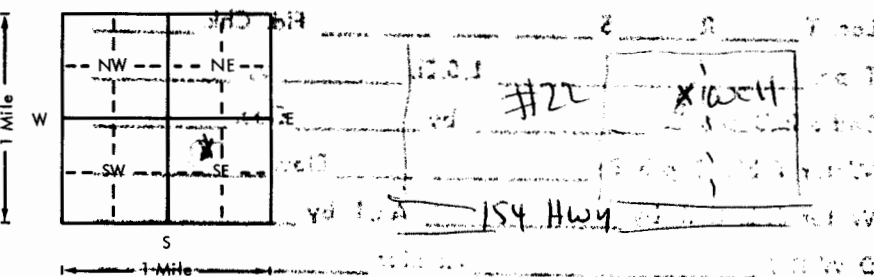


USE TYPEWRITER OR BALL
POINT PEN-PRESS FIRMLY,
PRINT CLEARLY.

WATER WELL RECORD
KSA 82a-1201-1215

Kansas Department of Health and
Environment-Division of Environment
(Water well Contractors)
Topeka, Kansas 66620

1. Location of well:		Fraction	Section number	Township number	Range number
County: FORD		SE SE NW NW SE 1/4 SE 1/4 NW 1/4	22	T 28 S	R 21 E/W
2. Distance and direction from nearest town or city: 2 N - 1 3/4 E Street address of well location if in city: 1/4 N Bucklin			3. Owner of well: MARVIN PRICE R.R. or street: City, state, zip code: Mullinville, Kansas		
4. Locate with "X" in section below: 			6. Bore hole dia. 30 in. Completion date 2-23-77 Well depth 162 ft.		
5. Type and color of material			7. <input type="checkbox"/> Cable tool <input type="checkbox"/> Rotary <input type="checkbox"/> Driven <input type="checkbox"/> Dug <input type="checkbox"/> Hollow rod <input type="checkbox"/> Jetted <input type="checkbox"/> Bored <input checked="" type="checkbox"/> Reverse rotary		
Top Soil & Clay			8. Use: <input type="checkbox"/> Domestic <input type="checkbox"/> Public supply <input type="checkbox"/> Industry <input checked="" type="checkbox"/> Irrigation <input type="checkbox"/> Air conditioning <input type="checkbox"/> Stock <input type="checkbox"/> Lawn <input type="checkbox"/> Oil field water <input type="checkbox"/> Other		
Sand & Gravel			9. Casing: Material IRON Height: Above or below Threaded <input type="checkbox"/> Welded <input checked="" type="checkbox"/> Surface 12 in. RMP <input type="checkbox"/> PVC <input type="checkbox"/> Weight 37 lbs./ft. Dia. 16 in. to 122 ft. depth Wall Thickness: inches or Dia. <input type="checkbox"/> in. to <input type="checkbox"/> ft. depth gage No. 188		
Shale			10. Screen: Manufacturer's name DOERR Type IRON Dia. 16 Slot/gauze 3/16 Length 40 Set between 122 ft. and 162 ft. Gravel pack? YES Size range of material 1/4 x 5/8		
Brock 162'			11. Static water level: 2 mo./day/yr. ft. below land surface Date		
no water level			12. Pumping level below land surfaces: Not ft. after hrs. pumping g.p.m. ft. after hrs. pumping g.p.m. Estimated maximum yield g.p.m.		
			13. Water sample submitted: mo./day/yr. Yes <input checked="" type="checkbox"/> No <input type="checkbox"/> Date		
			14. Well head completion: Pitless adapter 12 inches above grade		
			15. Well grouted? YES With: <input type="checkbox"/> Neat cement <input type="checkbox"/> Bentonite <input checked="" type="checkbox"/> Concrete Depth: From 0 ft. to 10 ft.		
			16. Nearest source of possible contamination: None ft. Direction Type Well disinfected upon completion? Yes <input type="checkbox"/> No <input type="checkbox"/>		
			17. Pump: Could Not installed Manufacturer's name GOULD MANUFACTURING Model number HP 70 Volts Length of drop pipe ft. capacity g.p.m. Type: <input type="checkbox"/> Submersible <input checked="" type="checkbox"/> Turbine <input type="checkbox"/> Jet <input type="checkbox"/> Reciprocating <input type="checkbox"/> Centrifugal <input type="checkbox"/> Other		
18. Elevation:			20. Water well contractor's certification: This well was drilled under my jurisdiction and this report is true to the best of my knowledge and belief. Robert Brant & Son Drilling 217 Business name License No. Address Bucklin, Kansas Signed [Signature] 4-1-77 Date Authorized representative		
19. Remarks: 7000 3.19 162 22170					