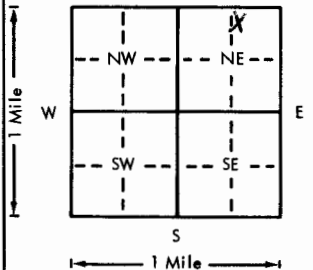
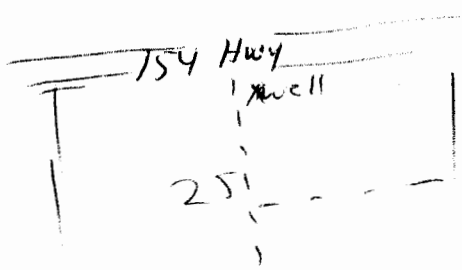


USE TYPEWRITER OR BALL  
POINT PEN-PRESS FIRMLY,  
PRINT CLEARLY.

WATER WELL RECORD  
KSA 82a-1201-1215

Kansas Department of Health and  
Environment-Division of Environment  
(Water well Contractors)  
Topeka, Kansas 66620

1. Location of well:		County	Fraction	Section number	Township number	Range number
		<del>FORD</del> <b>FORD</b>	<del>1/4 NW 1/4</del> <b>1/4 NW 1/4</b>	<del>25</del> <b>25</b>	T <b>28</b> S	R <b>21</b> E/W
2. Distance and direction from nearest town or city:		3 3/4 E Bucklin				
Street address of well location if in city:		on 954 Hwy				
3. Owner of well:		MARVIN PRICE				
R.R. or street:		Mullinville, Ks				
City, state, zip code:						
4. Locate with "X" in section below:		Sketch map:				
						
5. Type and color of material		From To				
Top Soil & Clay		0 45				
Sand & Clay		45 60				
Sand & Gravel		60 130				
Shale		130				
Rock 130'						
60'						
70' cat thick						
100'						
110'						
5130'</						