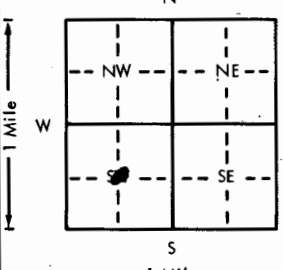
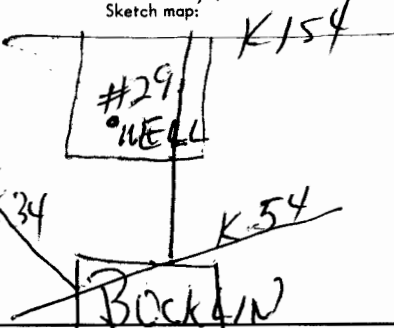


USE TYPEWRITER OR BALL
POINT PEN-PRESS FIRMLY,
PRINT CLEARLY.

WATER WELL RECORD
KSA 82a-1201-1215

Kansas Department of Health and
Environment-Division of Environment
(Water well Contractors)
Topeka, Kansas 66620

1. Location of well:		County Ford	Fraction SW 1/4 CENTER	Section number 29	Township number T28S	Range number R21W E/W		
2. Distance and direction from nearest town or city: Street address of well location if in city:			3. Owner of well: George Austin R.R. or street: Bucklin, Kansas City, state, zip code:					
4. Locate with "X" in section below: 			Sketch map: 			6. Bore hole dia. 28 in. Completion date 4-76 Well depth 155 ft.		
5. Type and color of material			From	To	7. <input type="checkbox"/> Cable tool <input type="checkbox"/> Rotary <input type="checkbox"/> Driven <input type="checkbox"/> Dug <input type="checkbox"/> Hollow rod <input type="checkbox"/> Jetted <input type="checkbox"/> Bored <input checked="" type="checkbox"/> Reverse rotary			
			Top Soil & Clay		0	60	8. Use: <input checked="" type="checkbox"/> Domestic <input type="checkbox"/> Public supply <input type="checkbox"/> Industry <input type="checkbox"/> Irrigation <input type="checkbox"/> Air conditioning <input type="checkbox"/> Stock <input type="checkbox"/> Lawn <input type="checkbox"/> Oil field water <input type="checkbox"/> Other	
			Sand & Gravel		60	125	9. Casing: Material Iron Height: Above or below Threaded <input type="checkbox"/> Welded <input checked="" type="checkbox"/> Surface <input type="checkbox"/> in. RMP <input type="checkbox"/> PVC <input type="checkbox"/> Weight <input type="checkbox"/> lbs./ft.	
			Clay		125	137	Dia. 16 in. to <input type="checkbox"/> ft. depth Wall Thickness: inches or Dia. <input type="checkbox"/> in. to <input type="checkbox"/> ft. depth gage No. <input type="checkbox"/>	
			Sand & Gravel		137	155	10. Screen: Manufacturer's name Doerr Type Iron Dia. 16 Slot/gauze 3/16 Length 40 Set between XXXX115 and 155 ft. ft. and <input type="checkbox"/> ft.	
Shale			155		Gravel pack? <input checked="" type="checkbox"/> Size range of material 1/4 by 5/8			
18. Elevation:			19. Remarks: FLAT			11. Static water level: <input type="checkbox"/> mo./day/yr. 90 ft. below land surface Date 7-76		
Topography: <input type="checkbox"/> Hill <input type="checkbox"/> Slope <input checked="" type="checkbox"/> Upland <input type="checkbox"/> Valley						12. Pumping level below land surfaces: 130 ft. after 2 hrs. pumping 1200 g.p.m. ft. after <input type="checkbox"/> hrs. pumping <input type="checkbox"/> g.p.m. Estimated maximum yield 1300 g.p.m.		
						13. Water sample submitted: None mo./day/yr. Yes <input type="checkbox"/> No <input checked="" type="checkbox"/> Date 4-76		
						14. Well head completion: <input type="checkbox"/> Pitless adapter <input type="checkbox"/> Inches above grade		
						15. Well grouted? Yes With: <input type="checkbox"/> Neat cement <input type="checkbox"/> Bentonite <input checked="" type="checkbox"/> Concrete Depth: From 0 ft. to 10 ft.		
						16. Nearest source of possible contamination: None ft. <input type="checkbox"/> Direction <input type="checkbox"/> Type <input type="checkbox"/> Well disinfected upon completion? <input type="checkbox"/> Yes <input checked="" type="checkbox"/> No		
						17. Pump: Fairbanks Not installed Manufacturer's name Fairbanks-Morse Model number 7000 HP 3/4 Volts <input type="checkbox"/> Length of drop pipe 140 ft. capacity 1200 g.p.m. Type: <input type="checkbox"/> Submersible <input checked="" type="checkbox"/> Turbine <input type="checkbox"/> Jet <input type="checkbox"/> Reciprocating <input type="checkbox"/> Centrifugal <input type="checkbox"/> Other		
						20. Water well contractor's certification: This well was drilled under my jurisdiction and this report is true to the best of my knowledge and belief. BRAH DRILLING 217 Business name License No. Address BUCKLIN KA. Signed PWBRAN Date 8-24-76 Authorized representative		