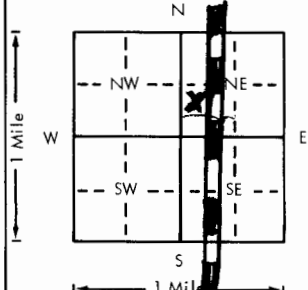


USE TYPEWRITER OR BALL  
POINT PEN-PRESS FIRMLY,  
PRINT CLEARLY.

WATER WELL RECORD  
KSA 82a-1201-1215

Kansas Department of Health and  
Environment-Division of Environment  
(Water well Contractors)  
Topeka, Kansas 66620

1. Location of well:		County <b>FORD</b>	Fraction <b>C 1/4 NW NE 1/4</b>	Section number <b>29</b>	Township number <b>T 28 S R 21 E</b>	Range number <b>21</b>
2. Distance and direction from nearest town or city: <b>1 1/2 N Bucklin KS</b>			3. Owner of well: <b>LEE BANKS OIL CO. #1 MARSH RERY</b> R.R. or street: <b>200 W DOUGLASS SUITE 550</b> City, state, zip code: <b>Wichita KS, 67202</b>			
4. Locate with "X" in section below: 			Sketch map:			
5. Type and color of material			From	To	6. Bore hole dia. <b>8 1/2</b> in. Completion date Well depth <b>160</b> ft. <b>8-19-81</b>	
<del>TOP SOIL</del>			0	5	7. Cable tool <input type="checkbox"/> Rotary <input type="checkbox"/> Driven <input type="checkbox"/> Dug <input type="checkbox"/> Hollow rod <input type="checkbox"/> Jetted <input type="checkbox"/> Bored <input type="checkbox"/> Reverse rotary	
CLAY			5	45	8. Use: Domestic <input type="checkbox"/> Public supply <input type="checkbox"/> Industry <input type="checkbox"/> Irrigation <input type="checkbox"/> Air conditioning <input type="checkbox"/> Stock <input type="checkbox"/> Lawn <input checked="" type="checkbox"/> Oil field water <input type="checkbox"/> Other	
SAND & CLAY			45	90	9. Casing: Material <b>PVC</b> Height <b>24"</b> Threaded <input type="checkbox"/> Welded <input type="checkbox"/> Surface <input type="checkbox"/> in. RMP <input type="checkbox"/> PVC <input checked="" type="checkbox"/> Weight <input type="checkbox"/> lbs./ft. Dia. <b>5</b> in. to <b>140</b> ft. depth Wall Thickness: inches or Dia. <input type="checkbox"/> in. to <input type="checkbox"/> ft. depth gage No. <b>SPR 21</b>	
GRAVEL			90	115	10. Screen: Manufacturer's name <b>Pearless PVC</b> Type <b>PVC</b> Dia. <b>5"</b> Slot/gauze <b>1/25</b> Length <b>20'</b> Set between <b>140</b> ft. and <b>160</b> ft. <input type="checkbox"/> ft. and <input type="checkbox"/> ft.	
CLAY			115	125	11. Static water level: <b>80</b> ft. below land surface Date <b>8-19-81</b> mo./day/yr.	
GRAVEL			125	160	12. Pumping level below land surfaces: <b>N/A</b> ____ ft. after ____ hrs. pumping ____ g.p.m. ____ ft. after ____ hrs. pumping ____ g.p.m. Estimated maximum yield <b>50</b> ____ g.p.m.	
					13. Water sample submitted: ____ mo./day/yr. Yes <input checked="" type="checkbox"/> No <input type="checkbox"/> Date ____	
					14. Well head completion: <b>24"</b> <input checked="" type="checkbox"/> Pitless adapter <b>24"</b> Inches above grade	
					15. Well grouted? <b>Yes</b> <input checked="" type="checkbox"/> With: Neat cement <input checked="" type="checkbox"/> Bentonite <input type="checkbox"/> Concrete <input type="checkbox"/> Depth: From <b>0</b> ft. to <b>10</b> ft.	
					16. Nearest source of possible contamination: <b>N/A</b> ft. ____ Direction ____ Type ____ Well disinfected upon completion? Yes <input type="checkbox"/> No <input type="checkbox"/>	
					17. Pump: <input checked="" type="checkbox"/> Not installed Manufacturer's name ____ Model number ____ HP ____ Volts ____ Length of drop pipe ____ ft. capacity ____ g.p.m. Type: ____ Submersible ____ Turbine ____ Jet ____ Reciprocating ____ Centrifugal ____ Other	
18. Elevation:			20. Water well contractor's certification: This well was drilled under my jurisdiction and this report is true to the best of my knowledge and belief. <b>BRAU DRILLING 217</b> Business name <b>Bucklin KS</b> License No. <b>8-19-81</b> Address <b>Rt 10</b> Signed <b>Rt 10</b> Date <b>8-19-81</b> Authorized representative			
19. Remarks:						