

WATER WELL RECORD

Form WWC-5


Division of Water Resources App. No.

20150401

1 LOCATION OF WATER WELL: County: Ford Fraction 1/4 NE 1/4 SE 1/4 SE 1/4 Section Number 8 Township No. T 28 S Range Number R 21 E W

Street/Rural Address of Well Location: 4 1/2 North of Bucklin Global Positioning System (GPS) information: Latitude: 37.61911 Longitude: 099.63268

2 WATER WELL OWNER: Vincent Oil RR#, Street Address, Box #: 155 N. Market- Ste 700 City, State, ZIP Code : Wichita, KS 67202

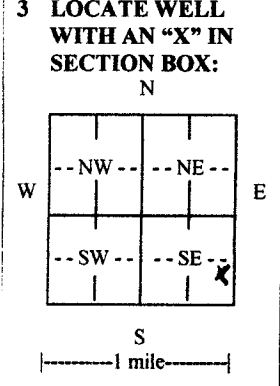

3 LOCATE WELL WITH AN 'X' IN SECTION BOX: 4 DEPTH OF COMPLETED WELL 87 ft. Depth(s) Groundwater Encountered (1) 53 ft. (2) ft. (3) ft. WELL'S STATIC WATER LEVEL 53 ft. below land surface measured on mo/day/yr. 12-21-15

5 TYPE OF CASING USED: Steel PVC Other CASING JOINTS: Glued Clamped Welded Threaded Casing diameter 5 in. to 87 ft. Diameter in. to ft. Diameter in. to ft. Casing height above land surface 18 in. Weight SDR-26 lbs./ft. Wall thickness or gauge No.

TYPE OF SCREEN OR PERFORATION MATERIAL: Steel Stainless Steel PVC Other (Specify) Brass Galvanized Steel None used (open hole) SCREEN OR PERFORATION OPENINGS ARE: Continuous slot Mill slot Gauze wrapped Torch cut Drilled holes None (open hole) Louvered shutter Key punched Wire wrapped Saw cut Other (specify)

6 GROUT MATERIAL: Neat cement Cement grout Bentonite Other Grout Intervals: From ft. to ft. From 20 ft. to 0 ft. From ft. to ft. What is the nearest source of possible contamination: Septic tank Lateral lines Pit privy Livestock pens Insecticide storage Other (specify below) Sewer lines Cesspool Sewage lagoon Fuel storage Abandoned water well Watertight sewer lines Seepage pit Feedyard Fertilizer storage Oil well/gas well None

Table with columns: FROM, TO, LITHOLOGIC LOG, FROM, TO, LITHO. LOG (cont.) or PLUGGING INTERVALS. Rows include Sand & clay, Sandy tan clay, Sand & gravel- med, Fire clay.

7 CONTRACTOR'S OR LANDOWNER'S CERTIFICATION: This water well was constructed, reconstructed, or plugged under my jurisdiction and was completed on (mo/day/year) 12-27-15 and this record is true to the best of my knowledge and belief. Kansas Water Well Contractor's License No. 134 This Water Well Record was completed on (mo/day/year) 1-18-16 under the business name of Rosencrantz- Bemis Ent Inc by (signature) Dan Allen

INSTRUCTIONS: Use typewriter or ball point pen. PLEASE PRESS FIRMLY and PRINT clearly. Please fill in blanks and check the correct answers. Send one copy to Kansas Department of Health and Environment, Bureau of Water, Geology Section, 1000 SW Jackson St., Suite 420, Topeka, Kansas 66612-1367. Telephone 785-296-5524. Send one copy to WATER WELL OWNER and retain one for your records. Include fee of \$5.00 for each constructed well. Visit us at http://www.kdheks.gov/waterwell/index.html