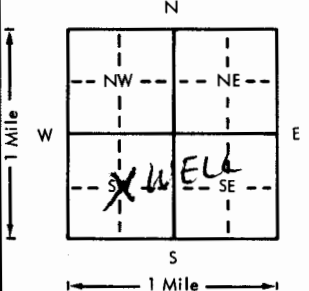
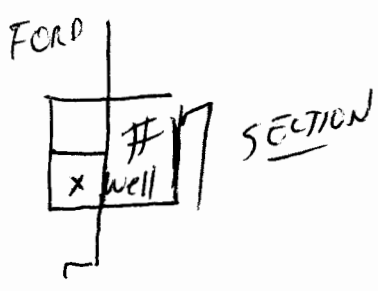


USE TYPEWRITER OR BALL
POINT PEN-PRESS FIRMLY,
PRINT CLEARLY.

WATER WELL RECORD
KSA 82a-1201-1215

Kansas Department of Health and
Environment-Division of Environment
(Water well Contractors)
Topeka, Kansas 66620

1. Location of well:	County FORD	Fraction SW 1/4 CENTER	Section number 7	Township number T 28 S	Range number R 23 E
2. Distance and direction from nearest town or city: 1 3/4 mi South FORD, KA		3. Owner of well: Earl Copeland R.R. or street: City, state, zip code: Bucklin, Ka.			
4. Locate with "X" in section below: 		Sketch map: 		6. Bore hole dia. 2 1/2 in. Completion date 8-5-76 Well depth 185 ft.	
5. Type and color of material		From	To	7. <input type="checkbox"/> Cable tool <input type="checkbox"/> Rotary <input type="checkbox"/> Driven <input type="checkbox"/> Dug <input type="checkbox"/> Hollow rod <input type="checkbox"/> Jetted <input type="checkbox"/> Bored <input checked="" type="checkbox"/> Reverse rotary	
TOP SOIL			0-10	8. Use: <input type="checkbox"/> Domestic <input type="checkbox"/> Public supply <input type="checkbox"/> Industry <input checked="" type="checkbox"/> Irrigation <input type="checkbox"/> Air conditioning <input type="checkbox"/> Stock <input type="checkbox"/> Lawn <input type="checkbox"/> Oil field water <input type="checkbox"/> Other	
CLAY			10-110	9. Casing: Material IRON Height: Above or below Threaded <input type="checkbox"/> Welded <input checked="" type="checkbox"/> Surface 12 in. RMP <input type="checkbox"/> PVC <input type="checkbox"/> Weight 34 lbs./ft. Dia. 1 1/2 in. to 1 1/2 ft. depth Wall Thickness: inches or Dia. <input type="checkbox"/> in. to <input type="checkbox"/> ft. depth gage No. 1188	
SAND + GRAVEL			110-185	10. Screen: Manufacturer's name DEER METAL Type IRON Dia. 1 1/2 Slot/gauze 3/16 Length 60" Set between 125 ft. and 185 ft. Gravel pack? <input checked="" type="checkbox"/> Size range of material 4 x 3/8"	
				11. Static water level: <input type="checkbox"/> mo./day/yr. 110 ft. below land surface Date Aug 10-76	
				12. Pumping level below land surfaces: 110 ft. after 3 hrs. pumping 800 g.p.m. ft. after hrs. pumping g.p.m. Estimated maximum yield g.p.m.	
				13. Water sample submitted: <input type="checkbox"/> mo./day/yr. Yes <input checked="" type="checkbox"/> No Date	
				14. Well head completion: <input type="checkbox"/> Pitless adapter 12 Inches above grade	
				15. Well grouted? <input checked="" type="checkbox"/> With: <input type="checkbox"/> Neat cement <input type="checkbox"/> Bentonite <input checked="" type="checkbox"/> Concrete Depth: From 0 ft. to 10 ft.	
				16. Nearest source of possible contamination: ft. NONE Direction Type Well disinfected upon completion? Yes <input checked="" type="checkbox"/> No	
				17. Pump: <input type="checkbox"/> Not installed Manufacturer's name FAIRBANKS MORSE Model number 7000 HP 3/4 Volts Length of drop pipe 180 ft. capacity 1000 g.p.m. Type: <input type="checkbox"/> Submersible <input checked="" type="checkbox"/> Turbine <input type="checkbox"/> Jet <input type="checkbox"/> Reciprocating <input type="checkbox"/> Centrifugal <input type="checkbox"/> Other	
18. Elevation: FLAT		19. Remarks:		20. Water well contractor's certification: This well was drilled under my jurisdiction and this report is true to the best of my knowledge and belief. BRAN Drilling 217 Business name License No. Address Bucklin KA Signed R. W. BRAN Date 8-27-76 Authorized representative	