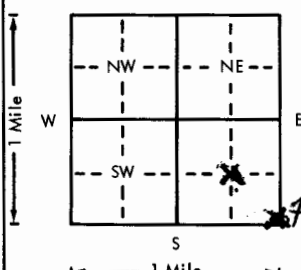


USE TYPEWRITER OR BALL
POINT PEN-PRESS FIRMLY,
PRINT CLEARLY.

WATER WELL RECORD
KSA 82a-1201-1215

Kansas Department of Health and
Environment-Division of Environment
(Water well Contractors)
Topeka, Kansas 66620

1. Location of well:		County Ford	Fraction SE 1/4 1/4 1/4	Section number 11	Township number T 28 S	Range number R 22 W E/W
2. Distance and direction from nearest town or city: 4 W, 3 N, 1/2 W of Bucklin, Kansas Street address of well location if in city:				3. Owner of well: Paul Jenkins R.R. or street: City, state, zip code: Bucklin, Kansas		
4. Locate with "X" in section below: 				6. Bore hole dia. 8 28 in. Completion date 4-76 Well depth 120 ft.		
5. Type and color of material				7. <input type="checkbox"/> Cable tool <input type="checkbox"/> Rotary <input type="checkbox"/> Driven <input type="checkbox"/> Dug <input type="checkbox"/> Hollow rod <input type="checkbox"/> Jetted <input type="checkbox"/> Bored <input checked="" type="checkbox"/> Reverse rotary		
				8. Use: <input type="checkbox"/> Domestic <input type="checkbox"/> Public supply <input type="checkbox"/> Industry <input checked="" type="checkbox"/> Irrigation <input type="checkbox"/> Air conditioning <input type="checkbox"/> Stock <input type="checkbox"/> Lawn <input type="checkbox"/> Oil field water <input type="checkbox"/> Other		
				9. Casing: Material Iron Height: Above or below Threaded <input type="checkbox"/> Welded <input checked="" type="checkbox"/> Surface 12 in. RMP <input type="checkbox"/> PVC <input type="checkbox"/> Weight 34 lbs./ft. Dia. 16 in. to 120 ft. depth Wall Thickness: inches or Dia. <input type="checkbox"/> in. to <input type="checkbox"/> ft. depth gage No. 188		
				10. Screen: Manufacturer's name Doerr Type Iron Dia. 16 Slot/gauze 3/16 Length 40 Set between 80 ft. and 120 ft. ft. and <input type="checkbox"/> ft. Gravel pack? <input checked="" type="checkbox"/> Size range of material 1/4 by 5/8		
(Use a second sheet if needed)				11. Static water level: <input type="checkbox"/> mo./day/yr. 60 ft. below land surface Date Jan.		
				12. Pumping level below land surfaces: 100 ft. after 1 hrs. pumping 800 g.p.m. ft. after <input type="checkbox"/> hrs. pumping <input type="checkbox"/> g.p.m. Estimated maximum yield 1400 g.p.m.		
				13. Water sample submitted: NO mo./day/yr. Yes <input checked="" type="checkbox"/> No <input type="checkbox"/> Date		
				14. Well head completion: 7-76 Pitless adapter <input type="checkbox"/> Inches above grade		
				15. Well grouted? Yes With: <input type="checkbox"/> Neq cement <input type="checkbox"/> Bentonite <input checked="" type="checkbox"/> Concrete Depth: From <input type="checkbox"/> ft. to 10 ft.		
				16. Nearest source of possible contamination: None ft. <input type="checkbox"/> Direction <input type="checkbox"/> Type <input type="checkbox"/> Well disinfected upon completion? <input type="checkbox"/> Yes <input checked="" type="checkbox"/> No		
				17. Pump: Fairbanks Not installed Manufacturer's name Fairbanks Moore Model number 7000 HP 75 Volts 440 Length of drop pipe 100 ft. capacity 800 g.p.m. Type: <input type="checkbox"/> Submersible <input checked="" type="checkbox"/> Turbine <input type="checkbox"/> Jet <input type="checkbox"/> Reciprocating <input type="checkbox"/> Centrifugal <input type="checkbox"/> Other		
				18. Elevation:		
19. Remarks: upland + sloping farm with 8 pumps in it. Steep Run by me + cement in 10'				20. Water well contractor's certification: This well was drilled under my jurisdiction and this report is true to the best of my knowledge and belief. Alberta Bran 217 Business name License No. Address 8456 Bucklin Signed Alberta Bran Date 6-21-76 Authorized representative		