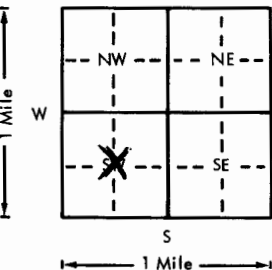
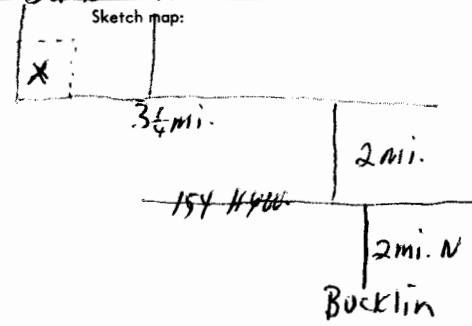


County FORD		Fraction SW 1/4 CENTER 1/4	Section number 11	Township number T 28	S S	Range number R 22	E/W (W)
1. Location of well:		2. Distance and direction from nearest town or city: 4 MILES NORTH - 3 1/4 MILES WEST OF BUCKLIN, KS.					
Street address of well location if in city:		3. Owner of well: MAYNARD & ESTES JR. R.R. or street: City, state, zip code: Bucklin, Kansas 67834					
4. Locate with "X" in section below: 		Sketch map: 				6. Bore hole dia. 28 in. Completion date Well depth 120 ft. OCT 6, 76	
						7. Cable tool ___ Rotary ___ Driven ___ Dug ___ Hollow rod ___ Jetted ___ Bored <input checked="" type="checkbox"/> Reverse rotary	
						8. Use: Domestic ___ Public supply ___ Industry <input checked="" type="checkbox"/> Irrigation ___ Air conditioning ___ Stock ___ Lawn ___ Oil field water ___ Other	
						9. Casing: Material IRON Height: Above or below Threaded ___ Welded <input checked="" type="checkbox"/> Surface 12 in. RMP ___ PVC ___ Weight 37 lbs./ft. Dia. 16 in. to ___ ft. depth Wall Thickness: inches or Dia. ___ in. to ___ ft. depth Gauge No. .188	
5. Type and color of material		From		To		10. Screen: Manufacturer's name DOELL METAL PRODUCTS	
TOP SOIL		0		10		Type IRON Dia. 16"	
Fine sand		10		50		Slot/gauze 3/16" Length 40'	
sand + GRAVEL		50		120		Set between 80 ft. and 120 ft. ft. and _____ ft.	
SHALE		120				Gravel pack? <input checked="" type="checkbox"/> YES Size range of material 1" x 3/8"	
						11. Static water level: _____ mo./day/yr. 70 ft. below land surface Date OCT 11, 76	
						12. Pumping level below land surfaces: 80 ft. after 4 hrs. pumping 1200 g.p.m. ____ ft. after ____ hrs. pumping ____ g.p.m. Estimated maximum yield 1600 g.p.m.	
						13. Water sample submitted: _____ mo./day/yr. Yes <input checked="" type="checkbox"/> No ___ Date _____	
						14. Well head completion: Pitless adapter 12" Inches above grade	
						15. Well grouted? <input checked="" type="checkbox"/> With: Neat cement ___ Bentonite ___ Concrete <input checked="" type="checkbox"/> Depth: From 0 ft. to 10 ft.	
						16. Nearest source of possible contamination: NONE ft. _____ Direction _____ Type _____ Well disinfected upon completion? Yes ___ No ___	
						17. Pump: Not installed Manufacturer's name Goulds Pumps Model number 12M1 HP 60 Volts 480 Length of drop pipe 100 ft. capacity 900 g.p.m. Type: ___ Submersible <input checked="" type="checkbox"/> Turbine ___ Jet ___ Reciprocating ___ Centrifugal ___ Other	
18. Elevation:		19. Remarks:		20. Water well contractor's certification: This well was drilled under my jurisdiction and this report is true to the best of my knowledge and belief. Alexander Brown Drillings 217 Business name License No. _____ Address Bucklin KS 67834 Signed RWB Authorized representative Date 10-28-			