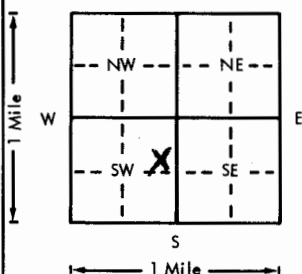
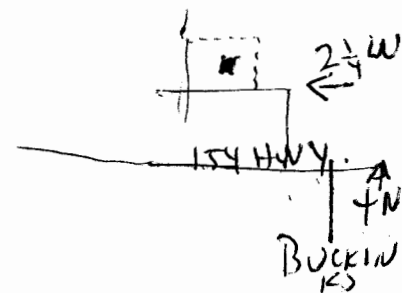


USE TYPEWRITER OR BALL  
POINT PEN-PRESS FIRMLY,  
PRINT CLEARLY.

WATER WELL RECORD  
KSA 82a-1201-1215

Kansas Department of Health and  
Environment-Division of Environment  
(Water well Contractors)  
Topeka, Kansas 66620

1. Location of well:	County <b>FORD</b>	Fraction <b>SW 1/4 NE 1/4 SE 1/4</b>	Section number <b>12</b>	Township number <b>T 28 S</b>	Range number <b>R 22 E</b>
2. Distance and direction from nearest town or city: Street address of well location if in city:	<b>4 MILES NORTH 2 1/4 MILES WEST OF BUCKLIN KS.</b>		3. Owner of well: <b>JOHN MELIA</b> R.R. or street: City, state, zip code: <b>DODGE CITY, KS.</b>		
4. Locate with "X" in section below:	Sketch map:		6. Bore hole dia. <b>1 1/2</b> in. Completion date <b>10-30-76</b> Well depth <b>82</b> ft.		
			7. Cable tool <input type="checkbox"/> Rotary <input type="checkbox"/> Driven <input type="checkbox"/> Dug <input type="checkbox"/> Hollow rod <input type="checkbox"/> Jetted <input type="checkbox"/> Bored <input checked="" type="checkbox"/> Reverse rotary		
5. Type and color of material			8. Use: Domestic <input type="checkbox"/> Public supply <input type="checkbox"/> Industry <input type="checkbox"/> Irrigation <input checked="" type="checkbox"/> Air conditioning <input type="checkbox"/> Stock <input type="checkbox"/> Lawn <input type="checkbox"/> Oil field water <input type="checkbox"/> Other <input type="checkbox"/>		
From To			9. Casing: Material <b>IRON</b> Height: Above or below Threaded <input type="checkbox"/> Welded <input checked="" type="checkbox"/> Surface <b>12</b> in. RMP <input type="checkbox"/> PVC <input type="checkbox"/> Weight <b>38</b> lbs./ft. Dia. <input type="checkbox"/> in. to <input type="checkbox"/> ft. depth Wall Thickness: inches or Dia. <input type="checkbox"/> in. to <input type="checkbox"/> ft. depth gage No. <b>188</b>		
TOPSOIL - FINE SAND - CLAY			10. Screen: Manufacturer's name <b>DOERR MFG</b> Type <b>IRON</b> Dia. <b>1 1/2</b> " Slot/gauze <b>3/16</b> " Length <b>40</b> " Set between <b>42</b> ft. and <b>82</b> ft. ft. and ft. Gravel pack? <input checked="" type="checkbox"/> Size range of material <b>1/4 X 5/8</b>		
CLAY - FINE SAND			11. Static water level: <b>41</b> ft. below land surface Date <b>10-30-76</b> mo./day/yr.		
SAND + GRAVEL Good - Excell			12. Pumping level below land surfaces: <b>64</b> ft. after <b>3 1/2</b> hrs. pumping <b>1200</b> g.p.m. ft. after hrs. pumping g.p.m. Estimated maximum yield <b>1400</b> g.p.m.		
SHALE			13. Water sample submitted: <b>YES</b> mo./day/yr. Yes <input checked="" type="checkbox"/> No <input type="checkbox"/> Date		
			14. Well head completion: Pitless adapter <b>12</b> inches above grade		
			15. Well grouted? <b>YES</b> With: Neat cement <input type="checkbox"/> Bentonite <input checked="" type="checkbox"/> Concrete <input type="checkbox"/> Depth: From <b>0</b> ft. to <b>10</b> ft.		
			16. Nearest source of possible contamination: <b>NONE</b> ft. Direction Type Well disinfected upon completion? Yes <input type="checkbox"/> No <input type="checkbox"/>		
			17. Pump: Not installed Manufacturer's name <b>GRUNDS PUMP</b> Model number <b>12M</b> HP <b>60</b> Volts Length of drop pipe <b>80</b> ft. capacity <b>1200</b> g.p.m. Type: <input type="checkbox"/> Submersible <input checked="" type="checkbox"/> Turbine <input type="checkbox"/> Jet <input type="checkbox"/> Reciprocating <input type="checkbox"/> Centrifugal <input type="checkbox"/> Other		
(Use a second sheet if needed)					
18. Elevation:	19. Remarks:		20. Water well contractor's certification: This well was drilled under my jurisdiction and this report is true to the best of my knowledge and belief. <b>BRAM DRILLING 217</b> Business name <b>BUCKLIN KS</b> License No. Address <b>2110</b> Signed <b>BRAM</b> Date <b>1/10</b> Authorized representative		