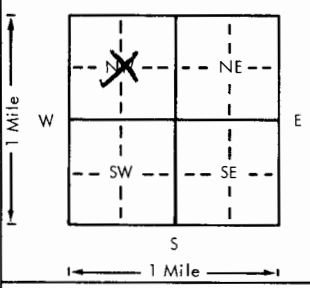


USE TYPEWRITER OR BALL
POINT PEN-PRESS FIRMLY,
PRINT CLEARLY.

WATER WELL RECORD
KSA 82a-1201-1215

Kansas Department of Health and
Environment-Division of Environment
(Water well Contractors)
Topeka, Kansas 66620

1. Location of well:		County FOND	Fraction Center NW	Section number 13	Township number T 28 S	Range number R 22 W
X Distance and direction from nearest town or city: 3 1/4 EAST - 2 S			3. Owner of well: PAUL JENKINS			
Street address of well location if in city: OFF FOND KS.			R.R. or street: Bucklin ks.			
			City, state, zip code: Bucklin ks.			
4. Locate with "X" in section below:			Sketch map:		6. Bore hole dia. 30" in. Completion date 8-10-79	
					Well depth 105 8-10-79	
5. Type and color of material			From	To	7. Cable tool <input type="checkbox"/> Rotary <input type="checkbox"/> Driven <input type="checkbox"/> Dug <input type="checkbox"/> Hollow rod <input type="checkbox"/> Jetted <input type="checkbox"/> Bored <input checked="" type="checkbox"/> Reverse rotary	
TOP SOIL			0	3	8. Use: Domestic <input type="checkbox"/> Public supply <input type="checkbox"/> Industry <input checked="" type="checkbox"/> Irrigation <input type="checkbox"/> Air conditioning <input type="checkbox"/> Stock <input type="checkbox"/> Lawn <input type="checkbox"/> Oil field water <input type="checkbox"/> Other <input type="checkbox"/>	
CLAY			3	45	9. Casing: Material STEEL Height: Above or below 12 in. Threaded <input type="checkbox"/> Welded <input checked="" type="checkbox"/> Surface 12 in. RMP 16 in. to 105 ft. depth. Weight 16 lbs./ft. Dia. 16 in. to 105 ft. depth. Wall thickness: 1/8 in. Dia. 16 in. to 105 ft. depth. Gauge No. 188	
Sand + Gravel			45	90	10. Screen: Manufacturer's name DOERR Type STEEL Dia. 16 Slot/gauze 65 Length 40 Set between 65 ft. and 105 ft. and 105 ft. Gravel pack? Yes Size range of material 1/4 X 5/8	
CLAY			90	95	11. Static water level: 45 ft. below land surface Date 8-10-79	
Gravel			95	105	12. Pumping level below land surfaces: 45 ft. after 1 hrs. pumping 750 g.p.m. 45 ft. after 1 hrs. pumping 750 g.p.m. Estimated maximum yield 750 g.p.m.	
SHALE			105		13. Water sample submitted: Yes <input checked="" type="checkbox"/> No <input type="checkbox"/> Date 8-10-79	
					14. Well head completion: 12" Pitless adapter 12" inches above grade	
					15. Well grouted? Yes With: Neat cement <input type="checkbox"/> Bentonite <input checked="" type="checkbox"/> Concrete <input type="checkbox"/> Depth: From 0 ft. to 10 ft.	
					16. Nearest source of possible contamination: NONE ft. Direction NONE Type NONE Well disinfected upon completion? Yes <input type="checkbox"/> No <input type="checkbox"/>	
					17. Pump: Goulds Not installed Manufacturer's name JLC Model number JLC HP 60 Volts 240 Length of drop pipe 890 ft. capacity 750 g.p.m. Type: <input type="checkbox"/> Submersible <input checked="" type="checkbox"/> Turbine <input type="checkbox"/> Jet <input type="checkbox"/> Reciprocating <input type="checkbox"/> Centrifugal <input type="checkbox"/> Other <input type="checkbox"/>	
					20. Water well contractor's certification: This well was drilled under my jurisdiction and this report is true to the best of my knowledge and belief. BRAN DRILL 217 Business name BUCKLIN KS License No. 81079 Address Rm 1079 Signed Rm 1079 Date 8-10-79 Authorized representative	
18. Elevation:		19. Remarks:				
Topography: <input checked="" type="checkbox"/> Hill <input checked="" type="checkbox"/> Slope <input type="checkbox"/> Upland <input type="checkbox"/> Valley						