USE TYPEWRITER OR BALL POINT PEN-PRESS FIRMLY, PRINT CLEARLY.

T R EW sec 1/4 1/4 1/4 No.

WATER WELL RECORD
KSA 82a-1201-1215

Kansas State Dept. Of Health
(Water Well Contractors)
Forbes-Bldg. 740
Topeka, Kansas 66620

1 Location of well:	County	Township name	Fraction	Section number	Town number	Range number
	Ford		C NW NW	20	28S	22W

Distance and direction from nearest town or city: 2½ S ½ W

Street address of well location if in city: Ford, KS

3 Owner of well: Abbert-Jones Inc.

Address: 830 Sutton Place Wichita, Ks.

Locate with "X" in section below:

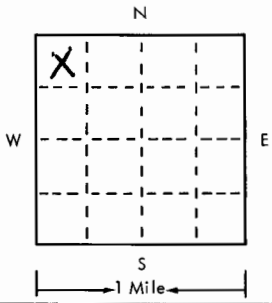

Sketch map:

4 Well depth: 235 ft. Date of completion 5-5-75
Well diameter 7 in.

5 ☐ Cable tool ☒ Rotary ☐ Driven ☐ Dug
☐ Hollow rod ☐ Jetted ☐ Bored ☐ Reverse rotary

6 Use: ☐ Domestic ☐ Public supply ☐ Industry
☐ Irrigation ☐ Air conditioning ☐ Commercial
☐ Test well ☒ Oil Rig

7 Casing: Material PVC Height: above/below
Threaded ☐ Welded ☐ Surface 12 in.
Diam. Weight ___ lbs./ft.
4 in. to 235 ft. depth Drive shoe? ☐ Yes ☒ No
___ in. to ___ ft. depth

2 Type and color of material	From	To
TOP Soil-Clay-Sand	0	140
Sand-Gravel	140	200
Sand + Clay	200	235
(use a second sheet if needed)		

8 Screen:
Manufacturer MPI
Type PVC Dia. 4"
Slot/gauze 1/16 Length 40
Set between 160 ft. and 200 ft.
Fittings:
Gravel pack ☒ Yes ☐ No Size range of material 1/8 - 3/4

9 Static water level:
90 ft. below land surface Date 5-5-75

10 Pumping level below land surfaces:
___ ft. after ___ hrs. pumping ___ g.p.m.
___ ft. after ___ hrs. pumping ___ g.p.m.
Estimated maximum yield 40 g.p.m.

11 Water sample submitted:
☐ Yes ☒ No Date ___

12 Well head completion: 12
☐ Pitless adapter ☒ Inches above grade

13 Well grouted? ☒ Yes ☐ No
☐ Neat cement ☒ Bentonite ☐ ___
Depth: From 0 ft. to 10 ft.

14 Nearest source of possible contamination:
ft. 100 Direction S Type Oil Test
Well disinfected upon completion? ☐ Yes ☒ No

15 Pump: ☒ Not installed
Manufacturer's name ___
Model number ___ HP ___ Volts ___
Length of drop pipe ___ ft. capacity ___ g.m.p.
Type:
☐ Submersible ☐ Turbine
☐ Jet ☐ Reciprocating
☐ Centrifugal ☐ Other

16 Remarks: elevation

Topography:
☐ Hill
☐ Slope
☒ Upland
☐ Valley

17 Water well contractor's certification:
This well was drilled under my jurisdiction and this report is true to the best of my knowledge and belief.
Business name Kelly's Water Well Serv License No. 186
Address R 2 Great Bend KS
Signed Kelly Price Date 5-10-75
Authorized representative

28 22W 20 Cnw Nw

Forward the white, blue and pink copies to the Kansas State Dept. Of Health.

Form WWC-5