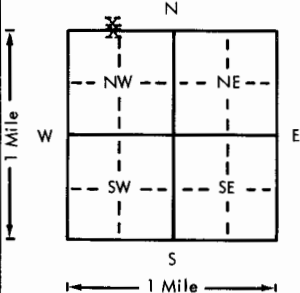


USE TYPEWRITER OR BALL
POINT PEN-PRESS FIRMLY,
PRINT CLEARLY.

WATER WELL RECORD
KSA 82a-1201-1215

Kansas Department of Health and
Environment-Division of Environment
(Water well Contractors)
Topeka, Kansas 66620

1. Location of well:		County Ford	Fraction NE 1/4 NW 1/4 NW 1/4	Section number 28	Township number T 28 S	Range number R 22 E/W
2. Distance and direction from nearest town or city: 3 mi south & 3/4 east of Ford Street address of well location if in city:				3. Owner of well: David White R.R. or street: Kingsdown, Kansas City, state, zip code:		
4. Locate with "X" in section below: 				Sketch map:		
5. Type and color of material				From	To	
Surface				0	3	
Brown clay				3	90	
Sandy brown clay				90	115	
Good fine to med. sand and gravel				115	140	
50% half med. sand-50% clay				140	146	
Half med. sand and fine gravel				146	155	
Half med. sand with 25% clay				155	165	
Good half med. sand and fine gravel				165	175	
Sandy brown clay				175	185	
35% brown rock and gravel mixed with clay				185	187	
Yellow clay				187	205	
Blue shale				205	210	
(Use a second sheet if needed)						
18. Elevation:		19. Remarks:		20. Water well contractor's certification: This well was drilled under my jurisdiction and this report is true to the best of my knowledge and belief. Ace-Hi International 190 Business name Dodge City, Kansas License No. Address 12-27-77 Signature Carl C. J. [illegible] Date 12-27-77 Authorized representative		