

COPY

ASSIGNMENT OF WATER WELL TO LANDOWNER

Feikert Farms LLC
PO Box 144
Bucklin, KS 67834-0144,

are the landowners on which a water well is located approximately

690' FSL & 2,110' FEL
Section 22-28S-22W
Ford County, Kansas.


Said water well was drilled on or about August 26, 2011
under Temporary Permit File No. 20110384.

As landowners, we hereby request that Ritchie Exploration, Inc. (operator) leave the water well unplugged, and we agree to properly maintain said well, and upon abandonment of said well, we will assume all responsibility for the plugging of said water well in accordance with the requirements of the Kansas Department of Health and Environment regulations K.A.R. 28-30-7. As consideration for the transfer of this well, we will allow operator to have free use of said well if the situation should arise in the future whereby the operator has additional drilling in the area.

This transfer to be effective December 27, 2011.


Feikert Farms, LLC

LANDOWNERS:

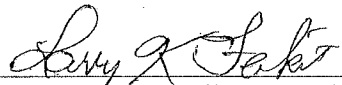

Larry K. Feikert, President

OPERATOR:

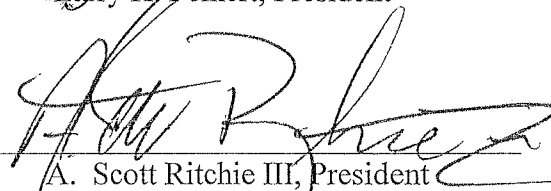

A. Scott Ritchie III, President
Ritchie Exploration, Inc.
PO Box 783188
Wichita, KS 67278-3188
(316) 691-9500

TO: Kansas Dept. of Health & Environment
Bureau of Water – Geology Section
1000 S.W. Jackson, Suite #420
Topeka, KS 66612-1367

Kansas Dept. of Agriculture
Division of Water Resources
109 SW 9th Street, 2nd Floor
Topeka, KS 66612-1283

RECEIVED

MAR 06 2012

BUREAU OF WATER

20110384

WATER WELL RECORD

Form WWC-5

Division of Water Resources App. No.

1 LOCATION OF WATER WELL: County: Ford		Fraction ¼ NW ¼ SW ¼ SE ¼	Section Number 22	Township No. T 28 S	Range Number R 22 <input type="checkbox"/> E <input checked="" type="checkbox"/> W	
Street/Rural Address of Well Location; if unknown, distance & direction from nearest town or intersection: If at owner's address, check here <input type="checkbox"/> 2 3/4 South, 1 3/4 East of Ford			Global Positioning System (GPS) information: Latitude: (in decimal degrees) Longitude: (in decimal degrees) Elevation: Datum: <input type="checkbox"/> WGS 84, <input type="checkbox"/> NAD 83, <input type="checkbox"/> NAD 27 Collection Method: <input type="checkbox"/> GPS unit (Make/Model:) <input type="checkbox"/> Digital Map/Photo, <input type="checkbox"/> Topographic Map, <input type="checkbox"/> Land Survey Est. Accuracy: <input type="checkbox"/> <3 m, <input type="checkbox"/> 3-5 m, <input type="checkbox"/> 5-15 m, <input type="checkbox"/> >15 m	
2 WATER WELL OWNER: Ritchie Exploration RR#, Street Address, Box #: P.O. Box 783188 City, State, ZIP Code : Wichita, Ks. 67278	
3 LOCATE WELL WITH AN "X" IN SECTION BOX: N <div style="text-align: center;"> </div> W E S -----1 mile-----		4 DEPTH OF COMPLETED WELL 153 ft. Depth(s) Groundwater Encountered (1)..... ft. (2)..... ft. (3)..... ft. WELL'S STATIC WATER LEVEL 87ft. below land surface measured on mo/day/yr. 8-26-11..... Pump test data: Well water was.....ft. after..... hours pumping..... gpm EST. YIELD. N/A.....gpm. Well water was.....ft. after..... hours pumping..... gpm Bore Hole Diameter 10.....in. to 153.....ft., andin. toft. WELL WATER TO BE USED AS: <input type="checkbox"/> Public water supply <input type="checkbox"/> Geothermal <input type="checkbox"/> Injection well <input type="checkbox"/> Domestic <input type="checkbox"/> Feedlot <input checked="" type="checkbox"/> Oil field water supply <input type="checkbox"/> Dewatering <input type="checkbox"/> Other (Specify below) <input type="checkbox"/> Irrigation <input type="checkbox"/> Industrial <input type="checkbox"/> Domestic-lawn & garden <input type="checkbox"/> Monitoring well Was a chemical/bacteriological sample submitted to Department? <input type="checkbox"/> Yes <input checked="" type="checkbox"/> No If yes, mo/day/yr sample was submitted..... Water well disinfected? <input checked="" type="checkbox"/> Yes <input type="checkbox"/> No	
5 TYPE OF CASING USED: <input type="checkbox"/> Steel <input checked="" type="checkbox"/> PVC <input type="checkbox"/> Other CASING JOINTS: <input checked="" type="checkbox"/> Glued <input type="checkbox"/> Clamped <input type="checkbox"/> Welded <input type="checkbox"/> Threaded Casing diameter .5..... in. to 153..... ft., Diameter in. to ft. Casing height above land surface...18..... in., Weight SDR-26.....lbs./ft., Wall thickness or gauge No. TYPE OF SCREEN OR PERFORATION MATERIAL: <input type="checkbox"/> Steel <input type="checkbox"/> Stainless Steel <input checked="" type="checkbox"/> PVC <input type="checkbox"/> Other (Specify) <input type="checkbox"/> Brass <input type="checkbox"/> Galvanized Steel <input type="checkbox"/> None used (open hole) SCREEN OR PERFORATION OPENINGS ARE: <input type="checkbox"/> Continuous slot <input type="checkbox"/> Mill slot <input type="checkbox"/> Gauze wrapped <input type="checkbox"/> Torch cut <input type="checkbox"/> Drilled holes <input type="checkbox"/> None (open hole) <input type="checkbox"/> Louvered shutter <input type="checkbox"/> Key punched <input type="checkbox"/> Wire wrapped <input checked="" type="checkbox"/> Saw cut <input type="checkbox"/> Other (specify) SCREEN-PERFORATED INTERVALS: From...153..... ft. to ...113..... ft. to ft. to ft. From..... ft. to ft., From ft. to ft. GRAVEL PACK INTERVALS: From...153..... ft. to ...20..... ft., From ft. to ft. From..... ft. to ft., From ft. to ft.	
6 GROUT MATERIAL: <input type="checkbox"/> Neat cement <input type="checkbox"/> Cement grout <input checked="" type="checkbox"/> Bentonite <input type="checkbox"/> Other Grout Intervals: From ft. to ft., From 20..... ft. to 0..... ft., From ft. to ft. What is the nearest source of possible contamination: <input type="checkbox"/> Septic tank <input type="checkbox"/> Lateral lines <input type="checkbox"/> Pit privy <input checked="" type="checkbox"/> Livestock pens <input type="checkbox"/> Insecticide storage <input type="checkbox"/> Other (specify below) <input type="checkbox"/> Sewer lines <input type="checkbox"/> Cesspool <input type="checkbox"/> Sewage lagoon <input type="checkbox"/> Fuel storage <input type="checkbox"/> Abandoned water well <input type="checkbox"/> Watertight sewer lines <input type="checkbox"/> Seepage pit <input type="checkbox"/> Feedyard <input type="checkbox"/> Fertilizer storage <input type="checkbox"/> Oil well/gas well Direction from well Northeast Distance from well ...100.....	
<table border="1" style="width:100%; border-collapse: collapse;"> <thead> <tr> <th style="width:10%;">FROM</th> <th style="width:10%;">TO</th> <th style="width:40%;">LITHOLOGIC LOG</th> <th style="width:10%;">FROM</th> <th style="width:10%;">TO</th> <th style="width:20%;">LITHO. LOG (cont.) or PLUGGING INTERVALS</th> </tr> </thead> <tbody> <tr> <td>0</td> <td>2</td> <td>Top soil</td> <td></td> <td></td> <td></td> </tr> <tr> <td>2</td> <td>81</td> <td>Tan clay</td> <td></td> <td></td> <td></td> </tr> <tr> <td>81</td> <td>144</td> <td>Sand & gravel- med</td> <td></td> <td></td> <td></td> </tr> <tr> <td>144</td> <td>153</td> <td>Dark gray shale</td> <td></td> <td></td> <td></td> </tr> <tr><td> </td><td> </td><td> </td><td> </td><td> </td><td> </td></tr> <tr><td> </td><td> </td><td> </td><td> </td><td> </td><td> </td></tr> <tr><td> </td><td> </td><td> </td><td> </td><td> </td><td> </td></tr> <tr><td> </td><td> </td><td> </td><td> </td><td> </td><td> </td></tr> <tr><td> </td><td> </td><td> </td><td> </td><td> </td><td> </td></tr> <tr><td> </td><td> </td><td> </td><td> </td><td> </td><td> </td></tr>
7 CONTRACTOR'S OR LANDOWNER'S CERTIFICATION: This water well was <input checked="" type="checkbox"/> constructed, <input type="checkbox"/> reconstructed, or <input type="checkbox"/> plugged under my jurisdiction and was completed on (mo/day/year) 8-26-11..... and this record is true to the best of my knowledge and belief. Kansas Water Well Contractor's License No. 134..... This Water Well Record was completed on (mo/day/year) 9-20-11..... under the business name of Rosencrantz, Bemis..... by (signature) <i>Rosencrantz Bemis</i>	
INSTRUCTIONS: Use typewriter or ball point pen. PLEASE PRESS FIRMLY and PRINT clearly. Please fill in blanks and check the correct answers. Send three copies (white, blue, pink) to Kansas Department of Health and Environment, Bureau of Water, Geology Section, 1000 SW Jackson St., Suite 420, Topeka, Kansas 66612-1367. Telephone 785-296-5522. Send one copy to WATER WELL OWNER and retain one for your records. Include fee of \$5.00 for each constructed well. Visit us at http://www.kdheks.gov/waterwell/index.html .	