

LOCATION OF WATER WELL: Fraction SE 1/4 - SE 1/4 - SW 1/4 Section Number 2 Township Number T 28 S Range Number R 23 EW

Distance and direction from nearest town or city street address of well if located within city?


2 1/2 W Ford Kansas

WATER WELL OWNER: Albert Blew

#, St. Address, Box # :

State, ZIP Code :

LOCATE WELL'S LOCATION WITH AN "X" IN SECTION BOX:

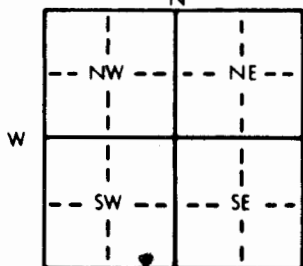

DEPTH OF COMPLETED WELL: 180 ft. ELEVATION:

Depth(s) Groundwater Encountered 1. 89 ft. 2. 89 ft. 3. 89 ft.

WELL'S STATIC WATER LEVEL 89 ft. below land surface measured on mo/day/yr 7-13-84

Pump test data: Well water was 89 ft. after 1 hours pumping 7 gpm

Est. Yield 25 gpm; Well water was 89 ft. after 1 hours pumping 7 gpm

Bore Hole Diameter 8 3/4 in. to 160 ft. and 160 in. to 160 ft.

WELL WATER TO BE USED AS: 5 Public water supply 8 Air conditioning 11 Injection well  
☒ Domestic 3 Feedlot 6 Oil field water supply 9 Dewatering 12 Other (Specify below)  
 2 Irrigation 4 Industrial 7 Lawn and garden only 10 Observation well

Was a chemical/bacteriological sample submitted to Department? Yes X No X; If yes, mo/day/yr sample was submitted

Water Well Disinfected? Yes X No

TYPE OF BLANK CASING USED:

1 Steel ☒ 3 RMP (SR)  
 2 PVC 4 ABS

5 Wrought iron

6 Asbestos-Cement

7 Fiberglass

8 Concrete tile

9 Other (specify below)

CASING JOINTS: Glued X Clamped

Welded

Threaded


Casing height above land surface 12 in., weight 12 lbs./ft. Wall thickness or gauge No. SDR-26

PE OF SCREEN OR PERFORATION MATERIAL:

1 Steel 3 Stainless steel  
 2 Brass 4 Galvanized steel

5 Fiberglass 6 Concrete tile

7 PVC

☒ 8 RMP (SR)

9 ABS

10 Asbestos-cement

11 Other (specify)

12 None used (open hole)

SCREEN OR PERFORATION OPENINGS ARE:

1 Continuous slot 3 Mill slot  
 2 Louvered shutter 4 Key punched

5 Gauzed wrapped

6 Wire wrapped

7 Torch cut

☒ 8 Saw cut

9 Drilled holes

10 Other (specify)

11 None (open hole)

SCREEN-PERFORATED INTERVALS: From 160 ft. to 180 ft. From 160 ft. to 180 ft. From 160 ft. to 180 ft.

GRAVEL PACK INTERVALS: From 145 ft. to 180 ft. From 145 ft. to 180 ft. From 145 ft. to 180 ft.

GROUT MATERIAL:

☒ 1 Neat cement

2 Cement grout

3 Bentonite

4 Other


What is the nearest source of possible contamination:

☒ 1 Septic tank 4 Lateral lines  
 2 Sewer lines 5 Cess pool  
 3 Watertight sewer lines 6 Seepage pit

7 Pit privy 8 Sewage lagoon  
 9 Feedyard

10 Livestock pens

11 Fuel storage

12 Fertilizer storage

13 Insecticide storage

14 Abandoned water well

15 Oil well/Gas well

16 Other (specify below)

Direction from well?

FROM TO LITHOLOGIC LOG

0 2 Top Soil  
2 74 Fine Clay  
74 104 Sand  
104 160 Clay  
160 180 Gravel

FROM TO LITHOLOGIC LOG

**RECEIVED**

JUL 09 1985

BUREAU OF OIL FIELD &  
 ENVIRONMENTAL GEOLOGY

CONTRACTOR'S OR LANDOWNER'S CERTIFICATION: This water well was ☒ (1) constructed, (2) reconstructed, or (3) plugged under my jurisdiction and was completed on (mo/day/year) 7-13-84 and this record is true to the best of my knowledge and belief. Kansas

Water Well Contractor's License No. 224 This Water Well Record was completed on (mo/day/yr) 7-6-85

For the business name of Carl Hayes Water Well Serv by (signature) Carl Hayes

INSTRUCTIONS: Use typewriter or ball point pen, PLEASE PRESS FIRMLY and PRINT clearly. Please fill in blanks, underline or circle the correct answers. Send top two copies to Kansas Department of Health and Environment, Division of Environment, Environmental Geology Section, Topeka, KS 66620. Send one to WATER WELL OWNER and retain one for your records.