
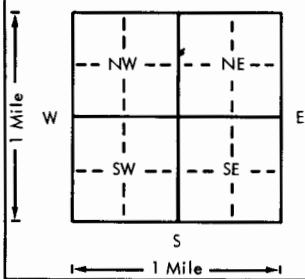


USE TYPEWRITER OR BALL
POINT PEN-PRESS FIRMLY,
PRINT CLEARLY.

WATER WELL RECORD
KSA 82a-1201-1215

Kansas Department of Health and
Environment-Division of Environment
(Water well Contractors)
Topeka, Kansas 66620

1. Location of well:		County Ford	Fraction NE 1/4 NE 1/4 T28S R23E	Section number 12	Township number T 28	Range number S R 23 E
2. Distance and direction from nearest town or city:		3 West of Ford		3. Owner of well: Exel Steep		
Street address of well location if in city:				R.R. or street: Sold, KS		
City, state, zip code:						
4. Locate with "X" in section below:		Sketch map: 		6. Bore hole dia. 1 1/4 in. Completion date 12-7-17 Well depth 105 ft.		
				7. <input checked="" type="checkbox"/> Cable tool <input checked="" type="checkbox"/> Rotary <input type="checkbox"/> Driven <input type="checkbox"/> Dug <input type="checkbox"/> Hollow rod <input type="checkbox"/> Jetted <input type="checkbox"/> Bored <input type="checkbox"/> Reverse rotary		
5. Type and color of material		From		To		8. Use: <input checked="" type="checkbox"/> Domestic <input type="checkbox"/> Public supply <input type="checkbox"/> Industry <input type="checkbox"/> Irrigation <input type="checkbox"/> Air conditioning <input type="checkbox"/> Stock <input type="checkbox"/> Lawn <input type="checkbox"/> Oil field water <input type="checkbox"/> Other
Topsoil + Clay		0		35		9. Casing: Material PST Height: Above or below Threaded <input type="checkbox"/> Welded <input type="checkbox"/> Surface 12 in. RMP <input type="checkbox"/> PVC <input checked="" type="checkbox"/> Weight 50 lbs./ft. Dia. 4 1/2 in. to 90 ft. depth Wall Thickness: inches or Dia. 105 in. to 90 ft. depth gage No. 40
Sand + Gravel		35		105		10. Screen: Manufacturer's name Home made Type <input type="checkbox"/> Dia. <input type="checkbox"/> Slot/gauze 3/16 in. Length 30 Set between 95 ft. and 105 ft. Gravel pack? <input checked="" type="checkbox"/> Size range of material 20-40
						11. Static water level: 30 ft. below land surface Date 12-7-17
						12. Pumping level below land surfaces: 30 ft. after 1 hrs. pumping 200 g.p.m. ft. after hrs. pumping g.p.m. Estimated maximum yield g.p.m.
						13. Water sample submitted: Yes <input checked="" type="checkbox"/> No <input type="checkbox"/> Date 12-7-17
						14. Well head completion: <input checked="" type="checkbox"/> Pitless adapter 12 inches above grade
						15. Well grouted? YES With: <input type="checkbox"/> Neat cement <input type="checkbox"/> Bentonite <input checked="" type="checkbox"/> Concrete Depth: From 0 ft. to 10 ft.
						16. Nearest source of possible contamination: none ft. Direction Type Well disinfected upon completion? <input type="checkbox"/> Yes <input type="checkbox"/> No
						17. Pump: Not installed Manufacturer's name Gould mfg Model number HP Vol Length of drop pipe 80 ft. capacity 10 g.p.m. Type: <input checked="" type="checkbox"/> Submersible <input checked="" type="checkbox"/> Turbine <input type="checkbox"/> Jet <input type="checkbox"/> Reciprocating <input type="checkbox"/> Centrifugal <input type="checkbox"/> Other
18. Elevation:		19. Remarks:		20. Water well contractor's certification:		
Topography: <input type="checkbox"/> Hill <input type="checkbox"/> Slope <input checked="" type="checkbox"/> Upland <input type="checkbox"/> Valley		Dribbled in edge of field		This well was drilled under my jurisdiction and this report is true to the best of my knowledge and belief. Bram Dilling Co 217 Business name License No. Address Bucklin Kans Signed Albert W. Bram Date 1-11-18 Authorized representative		