


1 LOCATION OF WATER WELL:	Fraction	Section Number	Township Number	Range Number
County: Ford	NE 1/4 NE 1/4 SW 1/4	15	T 28 S	R 23 E/W

Distance and direction from nearest town or city street address of well if located within city?

Dodge City South 7 miles on Hwy. 283, 9 miles East, 2 South, 1 East, $\frac{1}{2}$ South, $\frac{1}{2}$ East

2	WATER WELL OWNER:	Eleanor Hawes	
	RR#, St. Address, Box # :	R. R. 1	Board of Agriculture, Division of Water Resources
	City, State, ZIP Code :	Ford, Kansas 67842	Application Number:

3 LOCATE WELL'S LOCATION WITH AN "X" IN SECTION BOX: 4 DEPTH OF COMPLETED WELL 158 ft. ELEVATION:

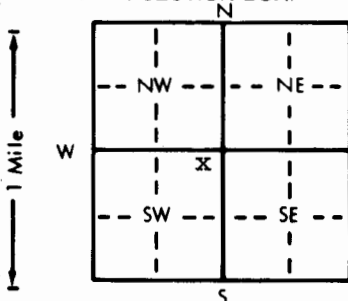

4 DEPTH OF COMPLETED WELL. 158 ft. ELEVATION:

Depth(s) Groundwater Encountered 1. ft. 2. ft. 3. ft.

WELL'S STATIC WATER LEVEL . . . 66 ft. below land surface measured on mo/day/yr . . . 10/13/81

Pump test data: Well water was . . . 122 . . . ft. after . . . 1 . . . hours pumping . . . 467 . . . gpm

Est. Yield 400 . . . gpm: Well water was ft. after hours pumping gpm

Bore Hole Diameter . . . 28 . . . in. to ft., and in. to ft.

WELL WATER TO BE USED AS:

1 Domestic	3 Feedlot	6 Oil field water supply	8 Air conditioning	11 Injection well
2 Irrigation	4 Industrial	7 Lawn and garden only	9 Dewatering	12 Other (Specify below)
			10 Observation well	

Was a chemical/bacteriological sample submitted to Department? Yes. No. X; If yes, mo/day/yr sample was submitted

Water Well Disinfected? Yes X No

5	TYPE OF BLANK CASING USED:		5 Wrought iron	8 Concrete tile	CASING JOINTS: Glued Clamped	
	1 Steel	3 RMP (SR)	6 Asbestos-Cement	9 Other (specify below)	Welded	X
	2 PVC	4 ABS	7 Fiberglass		Threaded	

Blank casing diameter 16 in. to 98 ft., Dia in. to ft., Dia in. to ft.
Casing height above land surface 12 in., weight 37 lbs./ft. Wall thickness or gauge No. 219

TYPE OF SCREEN OR PERFORATION MATERIAL:

1 Steel	3 Stainless steel	5 Fiberglass	7 PVC	10 Asbestos-cement
2 Brass	4 Galvanized steel	6 Concrete tile	8 RMP (SR)	11 Other (specify)
			9 ABS	12 None used (open hole)

SCREEN OR PERFORATION OPENINGS ARE:

1 Continuous slot	3 Mill slot	5 Gauzed wrapped	8 Saw cut	11 None (open hole)
2 Louvered shutter	4 Key punched	6 Wire wrapped	9 Drilled holes	
		7 Torch cut	10 Other (specify)	

SCREEN-PERFORATED INTERVALS: From 98 ft. to 158 ft., From ft. to ft.
From ft. to ft., From ft. to ft.
GRAVEL PACK INTERVALS: From 10 ft. to 158 ft., From ft. to ft.
From ft. to ft., From ft. to ft.

6 GROUT MATERIAL: 1 Neat cement 2 Cement grout 3 Bentonite 4 Other

Grout Intervals: From 0 ft. to 10 ft. From . ft. to . ft. From . ft. to . ft. From . ft. to . ft.

What is the nearest source of possible contamination:			10 Livestock pens	14 Abandoned water well
1 Septic tank	4 Lateral lines	7 Pit privy	11 Fuel storage	15 Oil well/Gas well
2 Sewer lines	5 Cess pool	8 Sewage lagoon	12 Fertilizer storage	16 Other (specify below)
3 Watertight sewer lines	6 Seepage pit	9 Feedyard	13 Insecticide storage	Unknown

Direction from well? _____ How many feet? _____

[illegible]

7] CONTRACTOR'S OR LANDOWNER'S CERTIFICATION: This water well was (1) constructed, (2) reconstructed, or (3) plugged under my jurisdiction and was completed on (mo/day/year) October 30, 1981 and this record is true to the best of my knowledge and belief. Kansas Water Well Contractor's License No. 102 This Water Well Record was completed on (mo/day/yr) November 18, 1981 under the business name of Layne-Western Company, Inc. by (signature) [Signature]

INSTRUCTIONS: Use typewriter or ball point pen, PLEASE PRESS FIRMLY and PRINT clearly. Please fill in blanks, underline or circle the correct answers. Send top three copies to Kansas Department of Health and Environment, Division of Environment, Environmental Geology Section, Topeka, KS 66620. Send one to WATER WELL OWNER and retain one for your records.