

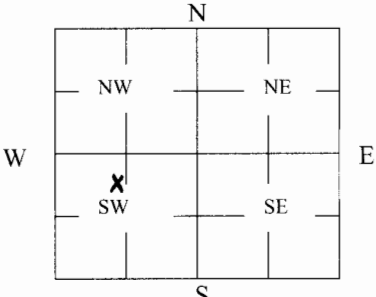
WATER WELL PLUGGING RECORD Form WWC-5P
KSA 82a-1212
ID NO.
20090065

1 LOCATION OF WATER WELL: County: Ford	Fraction E 1/2 XX NW 1/4 SW 1/4	Section Number 27	Township Number 28	Range Number 23 NW
---	---	-----------------------------	------------------------------	------------------------------

Distance and direction from nearest town or city street address of well if located within city?

3 3/4 South, 3 3/4 West of Ford

2 WATER WELL OWNER: Vincent Oil Corp 155 N. Market, Ste 700 RR#, St. Address, Box #: Wichita, Ks. 67202 City, State ZIP Code:	Global Positioning Systems (decimal degrees, min. of 4 digits) Latitude: _____ Longitude: _____ Elevation: _____ Datum: _____ Data Collection Method: _____
--	---

3 MARK WELL'S LOCATION WITH AN "X" IN SECTION BOX: 	4 DEPTH OF WELL <u>205</u> ft. WELL'S STATIC WATER LEVEL <u>147</u> ft. WELL WAS USED AS: <table> <tr> <td>1 Domestic</td> <td>5 Public Water Supply</td> <td>9 Dewatering</td> </tr> <tr> <td>2 Irrigation</td> <td>6 <u>Oil Field Water Supply</u></td> <td>10 Monitoring</td> </tr> <tr> <td>3 Feedlot</td> <td>7 Domestic (Lawn & Garden)</td> <td>11 Injection Well</td> </tr> <tr> <td>4 Industrial</td> <td>8 Air Conditioning</td> <td>12 Other _____</td> </tr> </table> Was a chemical/bacteriological sample submitted to Department? Yes _____ No <u>X</u>	1 Domestic	5 Public Water Supply	9 Dewatering	2 Irrigation	6 <u>Oil Field Water Supply</u>	10 Monitoring	3 Feedlot	7 Domestic (Lawn & Garden)	11 Injection Well	4 Industrial	8 Air Conditioning	12 Other _____
1 Domestic	5 Public Water Supply	9 Dewatering											
2 Irrigation	6 <u>Oil Field Water Supply</u>	10 Monitoring											
3 Feedlot	7 Domestic (Lawn & Garden)	11 Injection Well											
4 Industrial	8 Air Conditioning	12 Other _____											

5 TYPE OF BLANK CASING USED:				
1 Steel	3 RMP (SR)	5 Wrought	7 Fiberglass	9 Other (Specify below)
2 <u>PVC</u>	4 ABS	6 Asbestos-Cement	8 Concrete Tile	

Blank casing diameter 5 in. Was casing pulled? Yes _____ No X If yes, how much _____
 Casing height above or below land surface 36 in.

6 GROUT PLUG MATERIAL:	1 <u>Neat cement</u>	2 Cement grout	3 Bentonite	4 Other <u>hole plug</u>
-------------------------------	----------------------	----------------	-------------	--------------------------

Grout Plug Intervals: From 2 ft. to 0 ft., From _____ ft. to _____ ft., From 205 to 2 ft.

What is the nearest source of possible contamination:

1 Septic tank	6 Seepage pit	11 Fuel Storage	16 Other (specify below)
2 Sewer lines	7 Pit privy	12 Fertilizer storage	<u>None</u>
3 Watertight sewer lines	8 Sewage lagoon	13 Insecticide storage	
4 Lateral lines	9 Feedyard	14 Abandoned water well	Direction from well? _____
5 Cess pool	10 Livestock pens	15 Oil well/Gas well	How many feet? _____

FROM	TO	PLUGGING MATERIALS	FROM	TO	PLUGGING MATERIALS
205	2	Hole plug			
2	0	Cement			

7 CONTRACTOR'S OR LANDOWNER'S CERTIFICATION: This water well was plugged under my jurisdiction and was completed on (mo/day/year) 4-8-09 and this record is true to the best of my knowledge and belief. Kansas Water Well Contractor's License No. 134. This Water Well Record was completed on (mo/day/year) 4-17-09 under the business name of Rosencrantz- Bemis by (signature) Tora Alip

INSTRUCTIONS: Use typewriter or ballpoint pen. Please press firmly and print clearly. Please fill in blanks, underline or circle the correct answers. Send top three copies to Kansas Department of Health and Environment, Bureau of Water, Geology Section, 1000 SW Jackson St., Ste. 420, Topeka, Kansas 66612-1367. Telephone: 785/296-5522. Send one to Water Well Owner and retain one for your records. Visit us at <http://www.kdheks.gov/geo/waterwells>.