


WATER WELL RECORD

Form WWC-5

Division of Water Resources App. No.

20140935

1 LOCATION OF WATER WELL: County: Ford	Fraction ¼ NE ¼ NE ¼ SW ¼	Section Number 3	Township No. T 28 S	Range Number R 23 <input type="checkbox"/> E <input checked="" type="checkbox"/> W
Street/Rural Address of Well Location; if unknown, distance & direction from nearest town or intersection: If at owner's address, check here <input type="checkbox"/> 3 1/2 West of Ford		Global Positioning System (GPS) information: Latitude: (in decimal degrees) Longitude: (in decimal degrees) Elevation: Datum: <input type="checkbox"/> WGS 84, <input type="checkbox"/> NAD 83, <input type="checkbox"/> NAD 27 Collection Method: <input type="checkbox"/> GPS unit (Make/Model:) <input type="checkbox"/> Digital Map/Photo, <input type="checkbox"/> Topographic Map, <input type="checkbox"/> Land Survey Est. Accuracy: <input type="checkbox"/> <3 m, <input type="checkbox"/> 3-5 m, <input type="checkbox"/> 5-15 m, <input type="checkbox"/> >15 m		
2 WATER WELL OWNER: Eadle Oil & Gas RR#, Street Address, Box #: 2525 Kell Blvd- ste 510 City, State, ZIP Code : Wichita Falls, TX 67308				

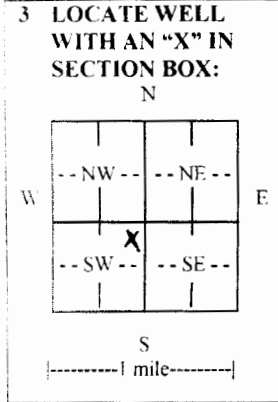

4 DEPTH OF COMPLETED WELL 223 ft.

Depth(s) Groundwater Encountered (1) ft. (2) ft. (3) ft.

WELL'S STATIC WATER LEVEL 112 ft. below land surface measured on mo/day/yr. 11-25-14

Pump test data: Well water was ft. after hours pumping gpm

EST. YIELD. N/A gpm. Well water was ft. after hours pumping gpm

Bore Hole Diameter 10 in. to 223 ft., and in. to ft.

WELL WATER TO BE USED AS: Public water supply Geothermal Injection well
 Domestic Feedlot Oil field water supply Dewatering Other (Specify below)
 Irrigation Industrial Domestic-lawn & garden Monitoring well

Was a chemical/bacteriological sample submitted to Department? Yes No

If yes, mo/day/yr sample was submitted.....

Water well disinfected? Yes No

5 TYPE OF CASING USED: Steel PVC Other

CASING JOINTS: Glued Clamped Welded Threaded

Casing diameter .5 in. to 223 ft., Diameter in. to ft., Diameter in. to ft.

Casing height above land surface 18 in., Weight SDR-26 lbs./ft., Wall thickness or gauge No.

TYPE OF SCREEN OR PERFORATION MATERIAL:
 Steel Stainless Steel PVC Other (Specify)
 Brass Galvanized Steel None used (open hole)

SCREEN OR PERFORATION OPENINGS ARE:
 Continuous slot Mill slot Gauze wrapped Torch cut Drilled holes None (open hole)
 Louvered shutter Key punched Wire wrapped Saw cut Other (specify)

SCREEN-PERFORATED INTERVALS: From 223 ft. to 183 ft., From ft. to ft.
 From ft. to ft., From ft. to ft.

GRAVEL PACK INTERVALS: From 223 ft. to 20 ft., From ft. to ft.
 From ft. to ft., From ft. to ft.

6 GROUT MATERIAL: Neat cement Cement grout Bentonite Other

Grout Intervals: From ft. to ft., From 20 ft. to 0 ft., From ft. to ft.

What is the nearest source of possible contamination:
 Septic tank Lateral lines Pit privy Livestock pens Insecticide storage Other (specify below)
 Sewer lines Cesspool Sewage lagoon Fuel storage Abandoned water well
 Watertight sewer lines Seepage pit Feedyard Fertilizer storage Oil well/gas well None

Direction from well Distance from well

FROM	TO	LITHOLOGIC LOG	FROM	TO	LITHO. LOG (cont.) or PLUGGING INTERVALS
0	3	Top soil			
3	36	Tan clay			
36	52	Sand			
52	80	Sandy tan clay			
80	134	Sand & gravel- med, tight			
134	146	Tan clay			
146	213	Sand & gravel- med, tight w/ clay streaks			
213	223	Gray shale			

7 CONTRACTOR'S OR LANDOWNER'S CERTIFICATION: This water well was constructed, reconstructed, or plugged under my jurisdiction and was completed on (mo/day/year) 11-25-14 and this record is true to the best of my knowledge and belief. Kansas Water Well Contractor's License No. 134 This Water Well Record was completed on (mo/day/year) 12-17-14 under the business name of Rosencrantz Bemis Ent Inc by (signature) *Don Aep*

INSTRUCTIONS: Use typewriter or ball point pen. PLEASE PRESS FIRMLY and PRINT clearly. Please fill in blanks and check the correct answers. Send three copies (white, blue, pink) to Kansas Department of Health and Environment, Bureau of Water, Geology Section, 1000 SW Jackson St., Suite 420, Topeka, Kansas 66612-1367. Telephone 785-296-5524. Send one copy to WATER WELL OWNER and retain one for your records. I include fee of \$5.00 for each constructed well. Visit us at <http://www.kdheks.gov/waterwell/index.html>.



ASSIGNMENT OF WATER WELL TO LANDOWNER

I, Shirley Riegel of 12366 US Hwy 400
(Landowner's address)

Wright KS am the landowner on which a water well is located in
(City) (State)
the NE quarter of the NE quarter of the SW quarter in Section 3, Township 28S,
Range 23 E/W in Ford County, Kansas which is approximately
2500 feet north/south, and 2500 feet east/west of the apparent SW section
corner. The water well was drilled in 11/2014 (month/year).

I hereby request that Eagle Oil & Gas Co. leave the water well,
(Operator name)

which was drilled by Temporary Water Permit # 20140935, unplugged, and I will
assume all responsibility for the plugging of said water well in accordance with the requirements
of the Kansas Department of Health and Environment regulation K.A.R. 28-30-7.

LANDOWNER: Shirley Riegel

Leslie Schoonover POA
(Signature) (Date) 1-28-15

Leslie Schoonover
(Print)

OPERATOR: EAGLE OIL & GAS Co.

Darrell S. Lehofer 2-3-15
(Signature) (Date)

By: Darrell S Lehofer CEO
(Agent)

IF ADDITIONAL LANDOWNER

(Signature) (Date)

(Print)

RECEIVED

FEB 11 2015

BUREAU OF WATER