


WATER WELL RECORD

Form WWC-5

Division of Water Resources App. No.

20140936

| | | | | |
|--|------------------------------|--|------------------------|---|
| 1 LOCATION OF WATER WELL: County: Ford | Fraction ¼ SE ¼ NE ¼ SW ¼ | Section Number 10 | Township No. T 28 S | Range Number R 23 <input type="checkbox"/> E <input checked="" type="checkbox"/> W |
| Street/Rural Address of Well Location; if unknown, distance & direction from nearest town or intersection: If at owner's address, check here <input type="checkbox"/> 3/4 South, 3 1/2 West of Ford | | Global Positioning System (GPS) information: Latitude: (in decimal degrees) Longitude: (in decimal degrees) Elevation: Datum: <input type="checkbox"/> WGS 84, <input type="checkbox"/> NAD 83, <input type="checkbox"/> NAD 27 Collection Method: <input type="checkbox"/> GPS unit (Make/Model:) <input type="checkbox"/> Digital Map/Photo, <input type="checkbox"/> Topographic Map, <input type="checkbox"/> Land Survey Est. Accuracy: <input type="checkbox"/> <3 m, <input type="checkbox"/> 3-5 m, <input type="checkbox"/> 5-15 m, <input type="checkbox"/> >15 m | | |
| 2 WATER WELL OWNER: Eagle Oil & Gas RR#, Street Address, Box #: 2525 Kell Blvd- ste 510 City, State, ZIP Code : Wichita Falls, TX 67308 | | | | |

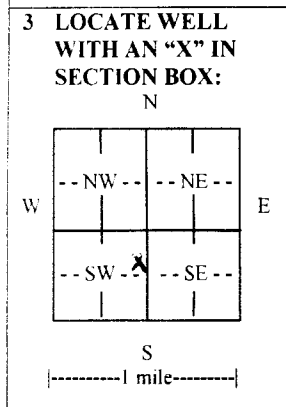

4 DEPTH OF COMPLETED WELL 177 ft.
Depth(s) Groundwater Encountered (1)..... ft. (2)..... ft. (3)..... ft.
WELL'S STATIC WATER LEVEL 92 ft. below land surface measured on mo/day/yr. 11-4-14.....
Pump test data: Well water was ft. after hours pumping gpm
EST. YIELD. N/A gpm. Well water was ft. after hours pumping gpm
Bore Hole Diameter 10 in. to 177 ft., and in. to ft.
WELL WATER TO BE USED AS: Public water supply Geothermal Injection well
 Domestic Feedlot Oil field water supply Dewatering Other (Specify below)
 Irrigation Industrial Domestic-lawn & garden Monitoring well
Was a chemical/bacteriological sample submitted to Department? Yes No
If yes, mo/day/yr sample was submitted.....
Water well disinfected? Yes No

5 TYPE OF CASING USED: Steel PVC Other
CASING JOINTS: Glued Clamped Welded Threaded
Casing diameter 5 in. to 177 ft., Diameter in. to ft., Diameter in. to ft.
Casing height above land surface 18 in., Weight SDR-26 lbs./ft., Wall thickness or gauge No.
TYPE OF SCREEN OR PERFORATION MATERIAL:
 Steel Stainless Steel PVC Other (Specify)
 Brass Galvanized Steel None used (open hole)
SCREEN OR PERFORATION OPENINGS ARE:
 Continuous slot Mill slot Gauze wrapped Torch cut Drilled holes None (open hole)
 Louvered shutter Key punched Wire wrapped Saw cut Other (specify)
SCREEN-PERFORATED INTERVALS: From 177 ft. to 137 ft., From ft. to ft.
From ft. to ft., From ft. to ft.
GRAVEL PACK INTERVALS: From 177 ft. to 20 ft., From ft. to ft.
From ft. to ft., From ft. to ft.

6 GROUT MATERIAL: Neat cement Cement grout Bentonite Other
Grout Intervals: From ft. to ft., From 20 ft. to 0 ft., From ft. to ft.
What is the nearest source of possible contamination:
 Septic tank Lateral lines Pit privy Livestock pens Insecticide storage Other (specify below)
 Sewer lines Cesspool Sewage lagoon Fuel storage Abandoned water well
 Watertight sewer lines Seepage pit Feedyard Fertilizer storage Oil well/gas well None
Direction from well Distance from well

| FROM | TO | LITHOLOGIC LOG | FROM | TO | LITHO. LOG (cont.) or PLUGGING INTERVALS |
|------|-----|-----------------------------------|------|----|--|
| 0 | 2 | Top soil | | | |
| 2 | 57 | Sandy tan clay | | | |
| 57 | 91 | Sand & gravel- med | | | |
| 91 | 114 | Sandy tan & gray clay | | | |
| 114 | 167 | Sand & gravel- med w/ clay streak | | | |
| 167 | 177 | Gray shale | | | |
| | | | | | |
| | | | | | |
| | | | | | |

7 CONTRACTOR'S OR LANDOWNER'S CERTIFICATION: This water well was constructed, reconstructed, or plugged under my jurisdiction and was completed on (mo/day/year) 11-4-14..... and this record is true to the best of my knowledge and belief. Kansas Water Well Contractor's License No. 134..... This Water Well Record was completed on (mo/day/year) 12-3-14..... under the business name of ..Rosencrantz Bemis Inc Ent..... by (signature) ..Karen Alf.....

INSTRUCTIONS: Use typewriter or ball point pen. PLEASE PRESS FIRMLY and PRINT clearly. Please fill in blanks and check the correct answers. Send three copies (white, blue, pink) to Kansas Department of Health and Environment, Bureau of Water, Geology Section, 1000 SW Jackson St., Suite 420, Topeka, Kansas 66612-1367. Telephone 785-296-5524. Send one copy to WATER WELL OWNER and retain one for your records. I include fee of \$5.00 for each constructed well. Visit us at <http://www.kdheks.gov/waterwell/index.html>.



ASSIGNMENT OF WATER WELL TO LANDOWNER

I, Brenda C Frey of 12070 Upland Rd
(Landowner's address)

Ford KS am the landowner on which a water well is located in
(City) (State)
the SE quarter of the NE quarter of the SW quarter in Section 10, Township 28S,
Range 23 E/W, in FORD County, Kansas which is approximately
1,400 feet north/south, and 2,500 feet east west of the apparent SW section
corner. The water well was drilled in 11 / 14 (month/year).

I hereby request that Eagle Oil & Gas Co. leave the water well,
(Operator name)

which was drilled by Temporary Water Permit # 20140936 unplugged, and I will
assume all responsibility for the plugging of said water well in accordance with the requirements
of the Kansas Department of Health and Environment regulation K.A.R. 28-30-7.

LANDOWNER:
Brenda C Frey 01/13/15
(Signature) (Date)
Brenda C Frey
(Print)

OPERATOR: EAGLE OIL & GAS CO.
Donall S. [Signature] 1/30/15
(Signature) (Date)
By: CEO
(Agent)

IF ADDITIONAL LANDOWNER
Rodney H. Frey
(Signature) (Date)
Rodney H. Frey
(Print)

RECEIVED
FEB 11 2015
BUREAU OF WATER