

WATER WELL RECORD

Form WWC-5

Division of Water Resources App. No.


20150347

1 LOCATION OF WATER WELL: County: Ford	Fraction ¼ SW ¼ NW ¼ SE ¼	Section Number 27	Township No. T 28 S	Range Number R 23 <input type="checkbox"/> E <input checked="" type="checkbox"/> W
--	------------------------------	----------------------	------------------------	---

Street/Rural Address of Well Location; if unknown, distance & direction from nearest town or intersection: If at owner's address, check here
3 1/4 North, 3 1/4 West of Kingsdown

Global Positioning System (GPS) information:
Latitude: 37.57726 (in decimal degrees)
Longitude: 099.82150 (in decimal degrees)
Elevation:
Datum: WGS 84, NAD 83, NAD 27
Collection Method:
 GPS unit (Make/Model:)
 Digital Map/Photo, Topographic Map, Land Survey
Est. Accuracy: <3 m, 3-5 m, 5-15 m, >15 m

2 WATER WELL OWNER: Vincent Oil
RR#, Street Address, Box #: 155 N. Market- Ste 700
City, State, ZIP Code : Wichita, KS 67202

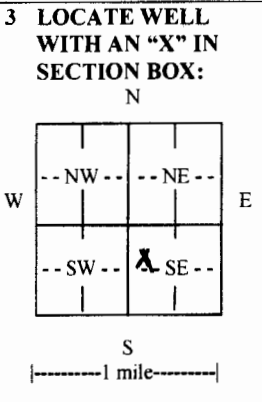

4 DEPTH OF COMPLETED WELL 192 ft.

Depth(s) Groundwater Encountered (1)..... ft. (2)..... ft. (3)..... ft.
WELL'S STATIC WATER LEVEL 139 ft. below land surface measured on mo/day/yr. 10-15-15
Pump test data: Well water was.....ft. after..... hours pumping..... gpm
EST. YIELD. N/A gpm. Well water was.....ft. after..... hours pumping..... gpm
Bore Hole Diameter 10 in. to 192 ft., andin. toft.
WELL WATER TO BE USED AS: Public water supply Geothermal Injection well
 Domestic Feedlot Oil field water supply Dewatering Other (Specify below)
 Irrigation Industrial Domestic-lawn & garden Monitoring well
Was a chemical/bacteriological sample submitted to Department? Yes No
If yes, mo/day/yr sample was submitted.....
Water well disinfected? Yes No

5 TYPE OF CASING USED: Steel PVC Other

CASING JOINTS: Glued Clamped Welded Threaded
Casing diameter 5 in. to 192 ft., Diameter in. to ft., Diameter in. to ft.
Casing height above land surface 18 in., Weight SDR 26 lbs./ft., Wall thickness or gauge No.
TYPE OF SCREEN OR PERFORATION MATERIAL:
 Steel Stainless Steel PVC Other (Specify)
 Brass Galvanized Steel None used (open hole)
SCREEN OR PERFORATION OPENINGS ARE:
 Continuous slot Mill slot Gauze wrapped Torch cut Drilled holes None (open hole)
 Louvered shutter Key punched Wire wrapped Saw cut Other (specify)
SCREEN-PERFORATED INTERVALS: From 192 ft. to 132 ft., From ft. to ft.
From ft. to ft., From ft. to ft.
GRAVEL PACK INTERVALS: From 192 ft. to 20 ft., From ft. to ft.
From ft. to ft., From ft. to ft.

6 GROUT MATERIAL: Neat cement Cement grout Bentonite Other

Grout Intervals: From ft. to ft., From 20 ft. to 0 ft., From ft. to ft.
What is the nearest source of possible contamination:
 Septic tank Lateral lines Pit privy Livestock pens Insecticide storage Other (specify below)
 Sewer lines Cesspool Sewage lagoon Fuel storage Abandoned water well
 Watertight sewer lines Seepage pit Feedyard Fertilizer storage Oil well/gas well None
Direction from well Distance from well

FROM	TO	LITHOLOGIC LOG	FROM	TO	LITHO. LOG (cont.) or PLUGGING INTERVALS
0	3	Top soil			
3	92	Tan clay & caliche			
92	119	Sandy tan clay & sand			
119	147	Sand & gravel- small to med, tight			
147	178	Sandy clay & sand- mixed			
178	185	Sand & gravel- small, tight			
185	192	Gray shale			

7 CONTRACTOR'S OR LANDOWNER'S CERTIFICATION: This water well was constructed, reconstructed, or plugged under my jurisdiction and was completed on (mo/day/year) 10-15-15 and this record is true to the best of my knowledge and belief.
Kansas Water Well Contractor's License No. 134 This Water Well Record was completed on (mo/day/year) 11-11-15
under the business name of ..Rosencrantz- Bemis Ent Inc by (signature) *Tina Altep*

INSTRUCTIONS: Use typewriter or ball point pen. PLEASE PRESS FIRMLY and PRINT clearly. Please fill in blanks and check the correct answers. Send one copy to Kansas Department of Health and Environment, Bureau of Water, Geology Section, 1000 SW Jackson St., Suite 420, Topeka, Kansas 66612-1367. Telephone 785-296-5524. Send one copy to WATER WELL OWNER and retain one for your records. Include fee of \$5.00 for each constructed well. Visit us at <http://www.kdheks.gov/waterwell/index.html>