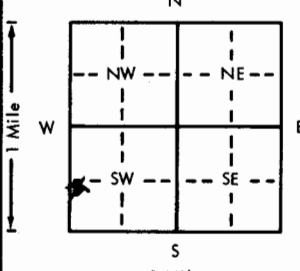


USE TYPEWRITER OR BALL
POINT PEN-PRESS FIRMLY,
PRINT CLEARLY.

WATER WELL RECORD
KSA 82a-1201-1215

Kansas Department of Health and
Environment-Division of Environment
(Water well Contractors)
Topeka, Kansas 66620

1. Location of well:		County FORD	Fraction SW 1/4 SW 1/4	Section number 5	Township number T 28	Range number S R 24	E/W E/W
2. Distance and direction from nearest town or city: 7 S 2 E Dodge City				3. Owner of well: Herb & Phoe			
Street address of well location if in city:				R.R. or street: RR 3			
City, state, zip code: Dodge City, KS 67801							
4. Locate with "X" in section below:		Sketch map:		6. Bore hole dia. 280 in. Completion date _____			
				Well depth 255 ft.			
				7. Cable tool _____ Rotary _____ Driven _____ Dug _____ Hollow rod _____ Jetted _____ Bored <input checked="" type="checkbox"/> Reverse rotary			
				8. Use: Domestic _____ Public supply _____ Industry _____ <input checked="" type="checkbox"/> Irrigation _____ Air conditioning _____ Stock _____ Lawn _____ Oil field water _____ Other _____			
				9. Casing: Material ST Height: Above or below _____ Threaded _____ Welded <input checked="" type="checkbox"/> Surface 10 in. RMP _____ PVC _____ Weight _____ lbs./ft. Dia. 16 in. to 240 ft. depth Wall Thickness: inches or _____ Dia. _____ in. to _____ ft. depth gage No. 3/16 gage			
5. Type and color of material		From		To		10. Screen: Manufacturer's name W.A. Brown	
Surface		0		3		Type Bridge Dia. 16	
clay		3		85		Slot/gauze 1/8 Length _____	
sand & clay layers		85		125		Set between 150.6 ft. and 250.6 ft.	
sand & gravel		125		139		Gravel pack? yes Size range of material 1/2" down	
hard stringers & clay		139		140		11. Static water level: _____ mo./day/yr.	
sand & gravel		140		164		140 ft. below land surface Date _____	
clay		164		169		12. Pumping level below land surfaces:	
sand & gravel		169		178		_____ ft. after _____ hrs. pumping _____ g.p.m.	
clay		178		179		_____ ft. after _____ hrs. pumping _____ g.p.m.	
med. sand		179		184		Estimated maximum yield _____ g.p.m.	
clay		184		185		13. Water sample submitted: _____ mo./day/yr.	
Cemented sand & clay streaks		185		195		Yes _____ No _____ Date _____	
med sand & gravel good		195		208		14. Well head completion:	
clay		208		210		_____ Pitless adapter _____ Inches above grade	
sand & gravel		210		248		15. Well grouted? yes	
clay & caliche		248		255		With: _____ Neat cement _____ Bentonite <input checked="" type="checkbox"/> Concrete	
						Depth: From 0 ft. to 10 ft.	
						16. Nearest source of possible contamination:	
						ft. _____ Direction _____ Type _____	
						Well disinfected upon completion? _____ Yes _____ No	
						17. Pump: <input checked="" type="checkbox"/> Not installed	
						Manufacturer's name _____	
						Model number _____ HP _____ Volts _____	
						Length of drop pipe _____ ft. capacity _____ g.p.m.	
						Type:	
						_____ Submersible _____ Turbine	
						_____ Jet _____ Reciprocating	
						_____ Centrifugal _____ Other	
18. Elevation:		19. Remarks:		20. Water well contractor's certification:			
Topography:				This well was drilled under my jurisdiction and this report			
<input checked="" type="checkbox"/> Hill				is true to the best of my knowledge and belief.			
<input checked="" type="checkbox"/> Slope				J.O. Johnson Drilling 183			
<input type="checkbox"/> Upland				Business name _____ License No. _____			
<input type="checkbox"/> Valley				Address _____			
				Signed Janice Alder Date 4/76			
				Authorized representative			