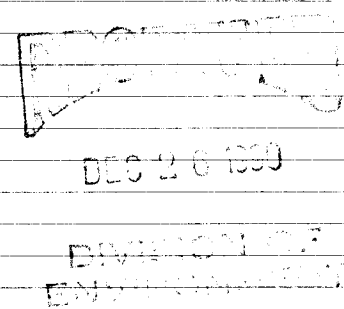


<b>1 LOCATION OF WATER WELL:</b>		Fraction		Section Number	Township Number	Range Number				
County: Ford		NW 1/4	NW 1/4	SW 1/4	5	T 28 S R 24 E/W				
Distance and direction from nearest town or city street address of well if located within city? From Dodge City, Ks - on hiway 283 - 6 miles South, 2 miles East and 1/2 mile South										
<b>2 WATER WELL OWNER:</b> <del>Maxx Fred Rosenberg</del> Herbert Spohr RR#, St. Address, Box # : <del>1805 E xx x x x x</del> Route #3 - Box 324 Board of Agriculture, Division of Water Resources City, State, ZIP Code : <del>Dodge City, Kansas 67801</del> Dodge City, Ks. 67801 Application Number:										
<b>3 LOCATE WELL'S LOCATION WITH AN "X" IN SECTION BOX:</b>		<b>4 DEPTH OF COMPLETED WELL</b> 154 ft. <b>ELEVATION:</b>								
<div style="text-align: center;">N 1 Mile W E S</div> <table border="1" style="margin: auto; text-align: center;"><tr><td>NW</td><td>NE</td></tr><tr><td>SW</td><td>SE</td></tr></table>		NW	NE	SW	SE	Depth(s) Groundwater Encountered 1. . . . . ft. 2. . . . . ft. 3. . . . . ft.				
		NW	NE							
		SW	SE							
		WELL'S STATIC WATER LEVEL . . . . . ft. below land surface measured on mo/day/yr								
Pump test data: Well water was . . . . . ft. after . . . . . hours pumping . . . . . gpm										
		Est. Yield . . . . . gpm: Well water was . . . . . ft. after . . . . . hours pumping . . . . . gpm								
		Bore Hole Diameter . . . . . in. to . . . . . ft., and . . . . . in. to . . . . . ft.								
		<b>WELL WATER TO BE USED AS:</b> 5 Public water supply 8 Air conditioning 11 Injection well								
		1 Domestic 3 Feedlot 6 Oil field water supply 9 Dewatering 12 Other (Specify below)								
		2 Irrigation 4 Industrial 7 Lawn and garden only 10 Monitoring well . . . . .								
		Was a chemical/bacteriological sample submitted to Department? Yes . . . . . No . . . . . If yes, mo/day/yr sample was submitted								
		Water Well Disinfected? Yes . . . . . No . . . . .								
<b>5 TYPE OF BLANK CASING USED:</b>										
1 Steel		3 RMP (SR)		8 Concrete tile		CASING JOINTS: Glued . . . . . Clamped . . . . .				
2 PVC		4 ABS		9 Other (specify below)		Welded . . . . .				
		7 Fiberglass				Threaded . . . . .				
Blank casing diameter . . . . . in. to . . . . . ft., Dia . . . . . in. to . . . . . ft., Dia . . . . . in. to . . . . . ft.										
Casing height above land surface . . . . . in., weight . . . . . lbs./ft. Wall thickness or gauge No. . . . .										
<b>TYPE OF SCREEN OR PERFORATION MATERIAL:</b>										
1 Steel		3 Stainless steel		7 PVC		10 Asbestos-cement				
2 Brass		4 Galvanized steel		8 RMP (SR)		11 Other (specify) . . . . .				
		5 Fiberglass		9 ABS		12 None used (open hole)				
		6 Concrete tile								
<b>SCREEN OR PERFORATION OPENINGS ARE:</b>										
1 Continuous slot		3 Mill slot		5 Gauzed wrapped		8 Saw cut				
2 Louvered shutter		4 Key punched		6 Wire wrapped		9 Drilled holes				
				7 Torch cut		10 Other (specify) . . . . .				
						11 None (open hole)				
<b>SCREEN-PERFORATED INTERVALS:</b> From . . . . . ft. to . . . . . ft., From . . . . . ft. to . . . . . ft.										
From . . . . . ft. to . . . . . ft., From . . . . . ft. to . . . . . ft.										
<b>GRAVEL PACK INTERVALS:</b> From . . . . . ft. to . . . . . ft., From . . . . . ft. to . . . . . ft.										
From . . . . . ft. to . . . . . ft., From . . . . . ft. to . . . . . ft.										
<b>6 GROUT MATERIAL:</b> 1 Neat cement 2 Cement grout 3 Bentonite 4 Other . . . . .										
Grout Intervals: From . . . . . ft. to . . . . . ft., From . . . . . ft. to . . . . . ft., From . . . . . ft. to . . . . . ft.										
What is the nearest source of possible contamination:										
1 Septic tank		4 Lateral lines		7 Pit privy		10 Livestock pens				
2 Sewer lines		5 Cess pool		8 Sewage lagoon		11 Fuel storage				
3 Watertight sewer lines		6 Seepage pit		9 Feedyard		12 Fertilizer storage				
						13 Insecticide storage				
						14 Abandoned water well				
						15 Oil well/Gas well				
						16 Other (specify below)				
Direction from well? How many feet?										
FROM	TO	LITHOLOGIC LOG	FROM	TO	PLUGGING INTERVALS					
0	5	cement			<div style="text-align: center;"></div>					
5	40	Bentonite plug								
40	154	Fill sand								
<b>7 CONTRACTOR'S OR LANDOWNER'S CERTIFICATION:</b> This water well was (1) constructed, (2) reconstructed, or (3) plugged under my jurisdiction and was completed on (mo/day/year) 11-23-90 and this record is true to the best of my knowledge and belief. Kansas Water Well Contractor's License No. 179. This Water Well Record was completed on (mo/day/yr) 12-4-90 under the business name of Joe's Well Service, Inc. Cimarron, Ks. by (signature) <i>Joe's Well Service</i>										
INSTRUCTIONS: Use typewriter or ball point pen. PLEASE PRESS FIRMLY and PRINT clearly. Please fill in blanks, underline or circle the correct answers. Send top three copies to Kansas Department of Health and Environment, Bureau of Water, Topeka, Kansas 66620-7320. Telephone: 913-296-5545. Send one to WATER WELL OWNER and retain one for your records.										