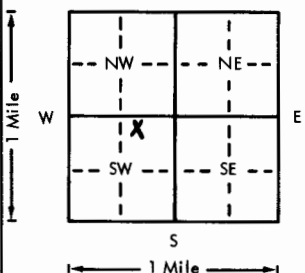


USE TYPEWRITER OR BALL
POINT PEN-PRESS FIRMLY,
PRINT CLEARLY.

WATER WELL RECORD
KSA 82a-1201-1215

Kansas Department of Health and
Environment-Division of Environment
(Water well Contractors)
Topeka, Kansas 66620

1. Location of well:		County Ford	Fraction NW 1/4 NE 1/4 SW 1/4	Section number 35	Township number T 28 S R 24 E	Range number AW
2. Distance and direction from nearest town or city: 3 Miles East, 6 1/2 N, 2 E, 1/2 N of Minneola, Kansas		3. Owner of well: Bernard Rooney R.R. or street: City, state, zip code: Minneola, Kansas				
4. Locate with "X" in section below:  1 Mile W E S 1 Mile		Sketch map: 1452' E and 92' S of the NW corner of the SW 1/4, Sec. 25, T28S R24W, Ford County, Kansas.		6. Bore hole dia. 28 in. Completion date 11-12-76 Well depth 421 ft.		
5. Type and color of material		From		To		7. <input type="checkbox"/> Cable tool <input type="checkbox"/> Rotary <input type="checkbox"/> Driven <input type="checkbox"/> Dug <input type="checkbox"/> Hollow rod <input type="checkbox"/> Jetted <input type="checkbox"/> Bored <input checked="" type="checkbox"/> Reverse rotary
Tan clay		0		100		8. Use: <input type="checkbox"/> Domestic <input type="checkbox"/> Public supply <input type="checkbox"/> Industry <input checked="" type="checkbox"/> Irrigation <input type="checkbox"/> Air conditioning <input type="checkbox"/> Stock <input type="checkbox"/> Lawn <input type="checkbox"/> Oil field water <input type="checkbox"/> Other
Fine to coarse sand clay streaks		100		186		9. Casing: Material Steel Height: Above or below Threaded <input type="checkbox"/> Welded <input checked="" type="checkbox"/> Surface 12 in. RMP <input type="checkbox"/> PVC <input type="checkbox"/> Weight 37 lbs./ft. Dia. 16 in. to 28 1/2 ft. depth Wall Thickness: inches or Dia. <input type="checkbox"/> in. to <input type="checkbox"/> ft. depth gage No. 219
Tan clay sand streaks		186		282		10. Screen: Manufacturer's name Doerr, Foster Type Louvered, mild steel to 16" Slot/gauze 1/8" Length 140 Set between 281 ft. and 421 ft. ft. and <input type="checkbox"/> ft. Gravel pack? <input checked="" type="checkbox"/> Size range of material 3mm
Fine to coarse sand		282		321		11. Static water level: <input type="checkbox"/> mo./day/yr. 97 ft. below land surface Date 8-23-76
Tan clay		321		350		12. Pumping level below land surfaces: 123 ft. after 1/2 hrs. pumping 1040 g.p.m. 176 ft. after 1 hrs. pumping 2618 g.p.m. Estimated maximum yield 2600 g.p.m.
Fine to coarse sand		350		450		13. Water sample submitted: <input type="checkbox"/> mo./day/yr. <input type="checkbox"/> Yes <input checked="" type="checkbox"/> No Date
Black shale		450		460		14. Well head completion: <input type="checkbox"/> Pitless adapter <input checked="" type="checkbox"/> Inches above grade
						15. Well grouted? yes With: <input type="checkbox"/> Neat cement <input checked="" type="checkbox"/> Bentonite <input type="checkbox"/> Concrete Depth: From 0 ft. to 10 ft.
						16. Nearest source of possible contamination: unk ft. <input type="checkbox"/> Direction <input type="checkbox"/> Type <input type="checkbox"/> Well disinfected upon completion? <input checked="" type="checkbox"/> Yes <input type="checkbox"/> No
						17. Pump: <input type="checkbox"/> Not installed Manufacturer's name Layne & Bowler Model number 12KEL HP 80 Volts <input type="checkbox"/> Length of drop pipe 200 ft. capacity 600 g.p.m. Type: <input type="checkbox"/> Submersible <input checked="" type="checkbox"/> Turbine <input type="checkbox"/> Jet <input type="checkbox"/> Reciprocating <input type="checkbox"/> Centrifugal <input type="checkbox"/> Other
						20. Water well contractor's certification: This well was drilled under my jurisdiction and this report is true to the best of my knowledge and belief. Layne-Western Co., Inc. 102 Business name License No. Address Garden City, Kansas Signed [Signature] Date 18 Nov 76 Authorized representative
18. Elevation:		19. Remarks: (Use a second sheet if needed)				
Topography: <input type="checkbox"/> Hill <input type="checkbox"/> Slope <input checked="" type="checkbox"/> Upland <input type="checkbox"/> Valley						