

1 LOCATION OF WATER WELL:	Fraction	Section Number	Township Number	Range Number
County: Ford	CN ¼ NE ¼ SW ¼	8	T 28 S	R 24 E/W

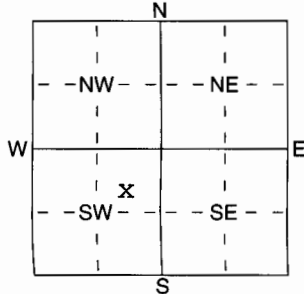
Distance and direction from nearest town or city street address of well if located within city?

8 miles South, 2 miles East 1½ Mile south 3/8 mile East2 WATER WELL OWNER: **Coraillee Bell (Norman Spohr)**RR#, St. Address, Box # : **403 El Carto Street**City, State, ZIP Code : **Dodge City, Ks. 67801-2831**

Board of Agriculture, Division of Water Resources

Application Number: **22864**3 LOCATE WELL'S LOCATION WITH 4 DEPTH OF COMPLETED WELL **282** ft. ELEVATION:

AN "X" IN SECTION BOX:

Depth(s) Groundwater Encountered: **1 208 227 255** ft. 3WELL'S STATIC WATER LEVEL **1.70** ft. below land surface measured on mo/day/yr **2-11-06**

Pump test data: Well water was ft. after hours pumping gpm

Est. Yield **700** gpm: Well water was ft. after hours pumping gpm

WELL WATER TO BE USED AS: 5 Public water supply 8 Air conditioning 11 Injection well

1 Domestic 3 Feedlot 6 Oil field water supply 9 Dewatering 12 Other (Specify below)

2 Irrigation 4 Industrial 7 Domestic (lawn & garden) 10 Monitoring well

Was a chemical/bacteriological sample submitted to Department? Yes No **X**; If yes, mo/day/yr sample was submittedWater Well Disinfected? Yes **X** No

5 TYPE OF BLANK CASING USED:

- 1 Steel 3 RMP (SR)
2 PVC 4 ABS

- 5 Wrought iron
6 Asbestos-Cement
7 Fiberglass

- 8 Concrete tile
9 Other (specify below)

CASING JOINTS: Glued **X** & Bolted
Welded
ThreadedBlank casing diameter **1.6** in. to **0-242** ft., Dia in. to ft., Dia in. to ft.Casing height above land surface **1.2** in., weight lbs./ft. Wall thickness or guage No. **SDR26**

TYPE OF SCREEN OR PERFORATION MATERIAL:

- 1 Steel 3 Stainless Steel
2 Brass 4 Galvanized Steel

- 5 Fiberglass
6 Concrete tile

- 7 PVC
8 RMP (SR)
9 ABS

- 10 Asbestos-Cement
11 Other (Specify)
12 None used (open hole)

SCREEN OR PERFORATION OPENINGS ARE:

- 1 Continuous slot 3 Mill slot
2 Louvered shutter 4 Key punched

- 5 Gauzed wrapped
6 Wire wrapped
7 Torch cut

- 8 Saw cut 11 None (open hole)
9 Drilled holes
10 Other (specify) ft.

SCREEN-PERFORATED INTERVALS: From **242** ft. to **262** ft., From **262** ft. to **282** ft.

From ft. to ft., From ft. to ft.

GRAVEL PACK INTERVALS: From **20** ft. to **282** ft., From ft. to ft.

From ft. to ft., From ft. to ft.

6 GROUT MATERIAL:

1 Neat cement

2 Cement grout

3 Bentonite

4 Other

Grout Intervals: From **20-16 Bentonite** ft., From **16-0 ft Grout** ft., From ft. to ft.

What is the nearest source of possible contamination:

- 1 Septic tank 4 Lateral lines
2 Sewer lines 5 Cess pool
3 Watertight sewer lines 6 Seepage pit

- 7 Pit privy
8 Sewage lagoon
9 Feedyard

- 10 Livestock pens 14 Abandoned water well
11 Fuel storage 15 Oil well/Gas well
12 Fertilizer storage 16 Other (specify below)
13 Insecticide storage

Direction from well?

How many feet?

FROM	TO	LITHOLOGIC LOG	FROM	TO	PLUGGING INTERVALS
	15	Topsoil & clay	180	181	Lime (very hard)
15	60	Clay	181	188	Clay & little lime
60	75	Clay & little lime	188	195	Sand (little fine)
75	90	Clay & little lime	195	207	Sand (little fine & 3' clay stks)
90	105	Clay & little lime	207	208	Lime (very hard)
105	120	Clay & little lime	208	215	Sand (little fine)
120	128	Clay & little lime (L. Hard)	215	225	Clay & little lime & fine sand
128	129	Lime (very hard)	225	227	Clay & little lime
129	135	Sand (fine & little tight)	227	240	Sand (fine)
135	150	Sand & Gravel	240	255	Sand (little loose & coarse)
150	165	Sand (coarse)	255	265	Sand (little loose & coarse)
165	171	Sand	265	270	Sand
171	174	Clay	270	275	Sand & clay stks/
174	180	Sand	275	285	Clay & little lime

7 CONTRACTOR'S OR LANDOWNER'S CERTIFICATION: This water well was (1) constructed, (2) reconstructed, or (3) plugged under my jurisdiction and was completed on (mo/day/year) **2-11-06** and this record is true to the best of my knowledge and belief. KansasWater Well Contractor's Licence No **223** This Water Well Record was completed on (mo/day/yr) **2-9-06**under the business name of **Dunham Drilling Inc.**by (signature) **Karen Dunham**