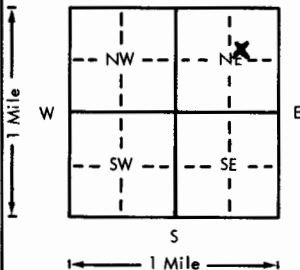


USE TYPEWRITER OR BALL
POINT PEN-PRESS FIRMLY,
PRINT CLEARLY.

WATER WELL RECORD
KSA 82a-1201-1215

Kansas Department of Health and
Environment-Division of Environment
(Water well Contractors)
Topeka, Kansas 66620

1. Location of well:		County FORD	Fraction SW 1/4 NE 1/4 NE 1/4	Section number 14	Township number T 28 S R 25 E	Range number 25
2. Distance and direction from nearest town or city: 13 miles S Dodge			3. Owner of well: CHARLES GEPFORD R.R. or street: City, state, zip code: Dodge City KS 67801			
4. Locate with "X" in section below:			Sketch map: Pasture		6. Bore hole dia. 8 in. Completion date 12/17/77 Well depth 220 ft.	
					7. <input checked="" type="checkbox"/> Cable tool <input checked="" type="checkbox"/> Rotary <input type="checkbox"/> Driven <input type="checkbox"/> Dug <input type="checkbox"/> Hollow rod <input type="checkbox"/> Jetted <input type="checkbox"/> Bored <input type="checkbox"/> Reverse rotary	
5. Type and color of material			From	To	8. Use: <input type="checkbox"/> Domestic <input type="checkbox"/> Public supply <input type="checkbox"/> Industry <input type="checkbox"/> Irrigation <input type="checkbox"/> Air conditioning <input checked="" type="checkbox"/> Stock <input type="checkbox"/> Lawn <input type="checkbox"/> Oil field water <input type="checkbox"/> Other	
Topsoil			0	4	9. Casing: Material PVC Height: Above or below Threaded <input type="checkbox"/> Welded <input type="checkbox"/> Surface 16 in. RMP <input type="checkbox"/> PVC 61w Weight 250 lbs./ft. Dia. 5 in. to 220 ft. depth Wall Thickness: inches or Dia. <input type="checkbox"/> in. to <input type="checkbox"/> ft. depth gage No. 250	
Clay			4	100	10. Screen: Manufacturer's name Jess & Levern Type PVC Dia. 5 Slot/gauze 11w Length 30' Set between <input type="checkbox"/> ft. and <input type="checkbox"/> ft. 190 ft. and 220 ft. Gravel pack? <input checked="" type="checkbox"/> Size range of material 11#	
Gravel			100	223	11. Static water level: <input type="checkbox"/> mo./day/yr. 110 ft. below land surface Date 7/12/77	
Shale			223	-	12. Pumping level below land surfaces: N/A <input type="checkbox"/> ft. after <input type="checkbox"/> hrs. pumping <input type="checkbox"/> g.p.m. <input type="checkbox"/> ft. after <input type="checkbox"/> hrs. pumping <input type="checkbox"/> g.p.m. Estimated maximum yield <input type="checkbox"/> g.p.m.	
					13. Water sample submitted: <input type="checkbox"/> mo./day/yr. Yes <input checked="" type="checkbox"/> No <input type="checkbox"/> Date <input type="checkbox"/>	
					14. Well head completion: <input type="checkbox"/> Pitless adapter <input type="checkbox"/> 16 inches above grade	
					15. Well grouted? <input checked="" type="checkbox"/> With: <input checked="" type="checkbox"/> Neat cement <input type="checkbox"/> Bentonite <input type="checkbox"/> Concrete Depth: From 0 ft. to 20 ft.	
					16. Nearest source of possible contamination: ft. <input type="checkbox"/> Direction <input type="checkbox"/> Type Pasture Well disinfected upon completion? <input checked="" type="checkbox"/> <input type="checkbox"/> No	
					17. Pump: <input checked="" type="checkbox"/> Not installed Manufacturer's name <input type="checkbox"/> Model number <input type="checkbox"/> HP <input type="checkbox"/> Volts <input type="checkbox"/> Length of drop pipe <input type="checkbox"/> ft. capacity <input type="checkbox"/> g.p.m. Type: <input type="checkbox"/> Submersible <input type="checkbox"/> Turbine <input type="checkbox"/> Jet <input type="checkbox"/> Reciprocating <input type="checkbox"/> Centrifugal <input type="checkbox"/> Other	
			(Use a second sheet if needed)			
18. Elevation:		19. Remarks:		20. Water well contractor's certification:		
Topography: <input checked="" type="checkbox"/> Hill <input type="checkbox"/> Slope <input type="checkbox"/> Upland <input type="checkbox"/> Valley		Pasture Well		This well was drilled under my jurisdiction and this report is true to the best of my knowledge and belief. CRAGG DRILLING Business name CRAGG License No. 111 Address 1308 South Second, DeKa Signed Randy Date 12/17/77 Authorized representative		