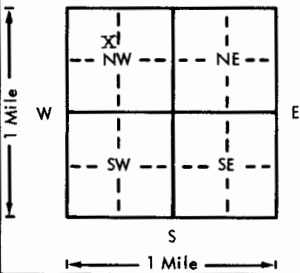


USE TYPEWRITER OR BALL  
POINT PEN-PRESS FIRMLY,  
PRINT CLEARLY.

WATER WELL RECORD  
KSA 82a-1201-1215

Kansas Department of Health and  
Environment-Division of Environment  
(Water well Contractors)  
Topeka, Kansas 66620

1. Location of well:		County <b>Ford</b>	Fraction <b>SE 1/4 NW 1/4 NW 1/4</b>	Section number <b>16</b>	Township number <b>T 28 S R 25 E</b>	Range number <b>25</b>
2. Distance and direction from nearest town or city: <b>8 mi south and 2 1/2 west of Dodge City</b>			3. Owner of well: <b>Bob Hessman</b> R.R. or street: <b>RFD 1</b> City, state, zip code: <b>Dodge City, Kansas</b>			
4. Locate with "X" in section below: 			6. Bore hole dia. <b>18 1/4</b> in. Completion date <b>3-26-76</b> Well depth <b>184</b> ft.			
5. Type and color of material			7. <input type="checkbox"/> Cable tool <input type="checkbox"/> Rotary <input type="checkbox"/> Driven <input type="checkbox"/> Dug <input type="checkbox"/> Hollow rod <input type="checkbox"/> Jetted <input type="checkbox"/> Bored <input checked="" type="checkbox"/> Reverse rotary			
			8. Use: <input type="checkbox"/> Domestic <input type="checkbox"/> Public supply <input type="checkbox"/> Industry <input checked="" type="checkbox"/> Irrigation <input type="checkbox"/> Air conditioning <input type="checkbox"/> Stock <input type="checkbox"/> Lawn <input type="checkbox"/> Oil field water <input type="checkbox"/> Other			
			9. Casing: Material <b>Meta</b> Height: Above or below Threaded <input type="checkbox"/> Welded <input checked="" type="checkbox"/> Surface <b>12</b> in. RMP <input type="checkbox"/> PVC <input type="checkbox"/> Weight <b>30.30</b> lbs./ft. Dia. <b>16</b> in. to <b>18 1/4</b> ft. depth Wall Thickness: inches or Dia. <input type="checkbox"/> in. to <input type="checkbox"/> ft. depth gage No. <b>179</b>			
			10. Screen: Manufacturer's name <b>W.A. Brown</b> Type <b>10% free-flt</b> Dia. <b>16</b> Slot/gauze <b>1/8</b> Length <b>100</b> Set between <b>84</b> ft. and <b>184</b> ft. ft. and <input type="checkbox"/> ft.			
			Gravel pack? <b>yes</b> Size range of material <b>3/8 down</b>			
(Use a second sheet if needed)			11. Static water level: <input type="checkbox"/> mo./day/yr. <b>94</b> ft. below land surface Date <b>2-26-76</b>			
			12. Pumping level below land surfaces: <b>115</b> ft. after <b>1</b> hrs. pumping <b>800</b> g.p.m. <b>130</b> ft. after <b>1</b> hrs. pumping <b>1800</b> g.p.m. Estimated maximum yield <b>2000</b> g.p.m.			
			13. Water sample submitted: <input type="checkbox"/> mo./day/yr. <input type="checkbox"/> Yes <input checked="" type="checkbox"/> No Date <input type="checkbox"/>			
			14. Well head completion: <input type="checkbox"/> Pitless adapter <input checked="" type="checkbox"/> <input type="checkbox"/> inches above grade			
			15. Well grouted? <b>Yes</b> With: <input type="checkbox"/> Neat cement <input type="checkbox"/> Bentonite <input checked="" type="checkbox"/> Concrete Depth: From <b>0</b> ft. to <b>10</b> ft.			
(Use a second sheet if needed)			16. Nearest source of possible contamination: <b>NA</b> ft. <input type="checkbox"/> Direction <input type="checkbox"/> Type <input type="checkbox"/> Well disinfected upon completion? <input type="checkbox"/> Yes <input checked="" type="checkbox"/> No			
			17. Pump: <input checked="" type="checkbox"/> Not installed Manufacturer's name <b>Goulds</b> Model number <b>12JMC</b> HP <b>100</b> Volts <input type="checkbox"/> Length of drop pipe <b>160</b> ft. capacity <b>800</b> g.p.m. Type: <input type="checkbox"/> Submersible <input checked="" type="checkbox"/> Turbine <input type="checkbox"/> Jet <input type="checkbox"/> Reciprocating <input type="checkbox"/> Centrifugal <input type="checkbox"/> Other			
			20. Water well contractor's certification: This well was drilled under my jurisdiction and this report is true to the best of my knowledge and belief. <b>Ace-Hi International 190</b> Business name <b>Dodge City, Kansas</b> License No. <input type="checkbox"/> Address <b>Carl G. Tuttle</b> Date <b>3-26-76</b> Signed <b>Carl G. Tuttle</b> Authorized representative			
			18. Elevation:			
			19. Remarks:			

28  
250  
16  
SE  
1/4  
1/4  
1/4