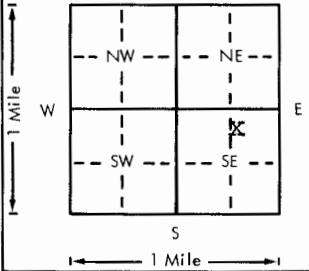


USE TYPEWRITER OR BALL  
POINT PEN-PRESS FIRMLY,  
PRINT CLEARLY.

WATER WELL RECORD  
KSA 82a-1201-1215

Kansas Department of Health and  
Environment-Division of Environment  
(Water well Contractors)  
Topeka, Kansas 66620

1. Location of well:		County <b>Ford</b>	Fraction <b>SW 1/4 NE 1/4 SE 1/4</b>	Section number <b>16</b>	Township number <b>T 28 S R 25 E</b>	Range number <b>25</b>
2. Distance and direction from nearest town or city: <b>9 south-2 west-3/4 south of Dodge City, Ks</b> Street address of well location if in city:				3. Owner of well: <b>Landowner-Mrs. W.L. Gough(Denver, Colo)</b> R.R. or street: <b>Temporary permit to Thunderbird Drilling</b> City, state, zip code: <b>7701 E. Kellogg, Wichita, Ks 67218</b>		
4. Locate with "X" in section below:		Sketch map:		6. Bore hole dia. <b>9</b> in. Completion date _____ Well depth <b>194</b> ft. <b>1-6-79</b>		
				7. <input checked="" type="checkbox"/> Cable tool <input checked="" type="checkbox"/> Rotary <input type="checkbox"/> Driven <input type="checkbox"/> Dug <input type="checkbox"/> Hollow rod <input type="checkbox"/> Jetted <input type="checkbox"/> Bored <input type="checkbox"/> Reverse rotary		
5. Type and color of material				8. Use: <input type="checkbox"/> Domestic <input type="checkbox"/> Public supply <input type="checkbox"/> Industry <input type="checkbox"/> Irrigation <input type="checkbox"/> Air conditioning <input type="checkbox"/> Stock <input type="checkbox"/> Lawn <input checked="" type="checkbox"/> Oil field water <input type="checkbox"/> Other		
				9. Casing: Material <b>plastic</b> Height: Above or below Threaded <input type="checkbox"/> Welded <input checked="" type="checkbox"/> Surface <b>24</b> in. RMP <b>Styreen</b> C <input type="checkbox"/> Weight <b>1.8</b> lbs./ft. Dia. <b>5</b> in. to <b>194</b> ft. depth Wall Thickness: inches or Dia. _____ in. to _____ ft. depth Gauge No. <b>250</b>		
				10. Screen: Manufacturer's name _____ <b>Jess &amp; Lowell</b> Type <b>sawed</b> Dia. <b>5"</b> Slot/gauze <b>.60</b> Length <b>100</b> Set between <b>94</b> ft. and <b>194</b> ft. _____ ft. and _____ ft. Gravel pack? <b>yes</b> Size range of material <b>3/8 down</b>		
				11. Static water level: _____ mo./day/yr. <b>68</b> ft. below land surface Date <b>1-6-79</b>		
				12. Pumping level below land surfaces: <b>NA</b> _____ ft. after _____ hrs. pumping _____ g.p.m. _____ ft. after _____ hrs. pumping _____ g.p.m. Estimated maximum yield <b>NA</b> _____ g.p.m.		
				13. Water sample submitted: _____ mo./day/yr. Yes <input checked="" type="checkbox"/> No <input type="checkbox"/> Date _____		
				14. Well head completion: _____ Pitless adapter <b>24</b> Inches above grade		
				15. Well grouted? <b>yes</b> With: _____ Neat cement _____ Bentonite <input checked="" type="checkbox"/> Concrete _____ Depth: From <b>0</b> ft. to <b>10</b> ft.		
				16. Nearest source of possible contamination: ft. <b>100</b> Direction <b>east</b> Type <b>creek</b> Well disinfected upon completion? <input checked="" type="checkbox"/> Yes _____ No _____		
				17. Pump: _____ Not installed Manufacturer's name _____ <b>Could's</b> Model number <b>UTM</b> HP <b>3</b> Volts <b>230</b> Length of drop pipe <b>168</b> ft. capacity <b>50</b> g.p.m. Type: <input checked="" type="checkbox"/> Submersible <input type="checkbox"/> Jet <input type="checkbox"/> Reciprocating <input type="checkbox"/> Centrifugal <input type="checkbox"/> Other _____ <b>X</b> <b>bull pump when oil well drilled</b>		
18. Elevation:		19. Remarks:		20. Water well contractor's certification: This well was drilled under my jurisdiction and this report is true to the best of my knowledge and belief. <b>Ace-Hi International 190</b> Business name _____ License No. _____ Address <b>Dodge City, Kansas 67801</b> Signed <b>Carl G. Jutila</b> Date <b>1-25-</b> Authorized representative		
Topography: ____ Hill ____ Slope ____ Upland <input checked="" type="checkbox"/> Valley						