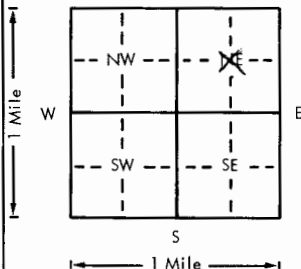


USE TYPEWRITER OR BALL
POINT PEN-PRESS FIRMLY,
PRINT CLEARLY.

WATER WELL RECORD
KSA 82a-1201-1215

Kansas Department of Health and
Environment-Division of Environment
(Water well Contractors)
Topeka, Kansas 66620

1. Location of well:		County Ford County	Fraction 1/4 NE 1/4	Section number 18	Township number 28	Range number 25	E/W E/W
2. Distance and direction from nearest town or city: 4 1/2 Southwest of Dodge City on Hiway 56, 6 South, 1 3/4 East, 1/2 South				3. Owner of well: P. W. Switzer R.R. or street: RFD 1 City, state, zip code: Dodge City, KS 67801			
4. Locate with "X" in section below: 				Sketch map:			
5. Type and color of material				From	To	6. Bore hole dia. 26 in. Completion date 6-31-79 Well depth 185 ft.	
Casing Schedule						7. Cable tool <input type="checkbox"/> Rotary <input type="checkbox"/> Driven <input type="checkbox"/> Dug <input type="checkbox"/> Hollow rod <input type="checkbox"/> Jetted <input type="checkbox"/> Bored <input checked="" type="checkbox"/> Reverse rotary	
0 - 105 Plain						8. Use: Domestic <input type="checkbox"/> Public supply <input type="checkbox"/> Industry <input checked="" type="checkbox"/> Irrigation <input type="checkbox"/> Air conditioning <input type="checkbox"/> Stock <input type="checkbox"/> Lawn <input type="checkbox"/> Oil field water <input type="checkbox"/> Other	
105 - 185 Perf.						9. Casing: Material Steel Height: Above or below Threaded <input type="checkbox"/> Welded <input checked="" type="checkbox"/> Surface 1 ft. in. RMP <input type="checkbox"/> PVC <input type="checkbox"/> Weight 36.87 lbs./ft. Dia. 16 in. to 185 ft. depth Wall thickness: inches or Dia. <input type="checkbox"/> in. to <input type="checkbox"/> ft. depth gage No. 219	
						10. Screen: Manufacturer's name Johnson Type Johnson Galv Dia. 100-16" Slot/gauze <input type="checkbox"/> Length <input type="checkbox"/> Set between <input type="checkbox"/> ft. and <input type="checkbox"/> ft. Gravel pack? yes Size range of material 1/2 to 5/8	
						11. Static water level: <input type="checkbox"/> mo./day/yr. 83 ft. below land surface Date 6-12-79	
						12. Pumping level below land surfaces: 110 ft. after 2 hrs. pumping 650 g.p.m. 129 unstable 4 hrs. pumping 950 w/air Estimated maximum yield 850 g.p.m.	
						13. Water sample submitted: <input type="checkbox"/> mo./day/yr. Yes <input checked="" type="checkbox"/> No <input type="checkbox"/> Date <input type="checkbox"/>	
						14. Well head completion: <input type="checkbox"/> Pitless adapter 1 ft. inches above grade	
						15. Well grouted? yes With: <input type="checkbox"/> Neat cement <input type="checkbox"/> Bentonite <input checked="" type="checkbox"/> Concrete Depth: From 0 ft. to 10 ft.	
						16. Nearest source of possible contamination: ft. <input type="checkbox"/> Direction N/A Type <input type="checkbox"/> Well disinfected upon completion? <input type="checkbox"/> Yes <input type="checkbox"/> No	
						17. Pump: <input checked="" type="checkbox"/> Not installed Manufacturer's name <input type="checkbox"/> Model number <input type="checkbox"/> HP <input type="checkbox"/> Volts <input type="checkbox"/> Length of drop pipe <input type="checkbox"/> ft. capacity <input type="checkbox"/> g.p.m. Type: <input type="checkbox"/> Submersible <input type="checkbox"/> Turbine <input type="checkbox"/> Jet <input type="checkbox"/> Reciprocating <input type="checkbox"/> Centrifugal <input type="checkbox"/> Other	
(Use a second sheet if needed)							
18. Elevation:		19. Remarks:		20. Water well contractor's certification:			
Topography: <input type="checkbox"/> Hill <input type="checkbox"/> Slope <input type="checkbox"/> Upland <input checked="" type="checkbox"/> Valley		Some one else's test we don't have a copy of it.		This well was drilled under my jurisdiction and this report is true to the best of my knowledge and belief. Minter Wilson Drilling Co. 208 Business name License No. Address Box A, Garden City, KS 67846 Signed <i>[Signature]</i> Date 8/17/79 Authorized representative			