


1 LOCATION OF WATER WELL: Fraction NW 1/4 NW 1/4 SE 1/4 Section Number 23 Township Number T 28 S Range Number R 25 E/W
 County: Ford

Distance and direction from nearest town or city street address of well if located within city?

10 Miles South of Dodge City

2 WATER WELL OWNER: City of Dodge City, Kansas P-1
 RR#, St. Address, Box #: 705 1st. Street Board of Agriculture, Division of Water Resources
 City, State, ZIP Code: Dodge City, Kansas 67801 Application Number: N/A

3 LOCATE WELL'S LOCATION WITH AN "X" IN SECTION BOX: 4 DEPTH OF COMPLETED WELL: 77 ft. ELEVATION: 2570

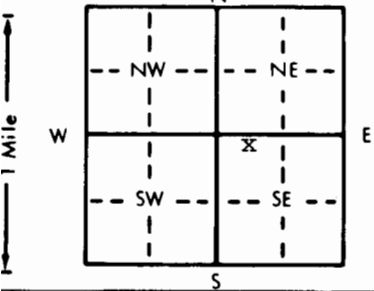

Depth(s) Groundwater Encountered 1. N/A ft. 2. ft. 3. ft.
 WELL'S STATIC WATER LEVEL: N/A ft. below land surface measured on mo/day/yr
 Pump test data: Well water was N/A ft. after hours pumping gpm
 Est. Yield: N/A gpm: Well water was ft. after hours pumping gpm
 Bore Hole Diameter: 7-7/8 in. to 77 ft. and in. to ft.
 WELL WATER TO BE USED AS:
 5 Public water supply 8 Air conditioning 11 Injection well
 1 Domestic 3 Feedlot 6 Oil field water supply 9 Dewatering 12 Other (Specify below)
 2 Irrigation 4 Industrial 7 Lawn and garden only 10 Observation well
 Was a chemical/bacteriological sample submitted to Department? Yes No X; If yes, mo/day/yr sample was submitted
 Water Well Disinfected? Yes X No

5 TYPE OF BLANK CASING USED:
 1 Steel 3 RMP (SR) 5 Wrought iron 8 Concrete tile CASING JOINTS: Glued X Clamped
 2 PVC 4 ABS 6 Asbestos-Cement 9 Other (specify below) Welded
 7 Fiberglass Threaded
 Blank casing diameter: 2 in. to 10 ft., Dia. 15-67 in. to 72-77 ft., Dia.
 Casing height above land surface: 24 in., weight lbs./ft. Wall thickness or gauge No. Sched. 40

TYPE OF SCREEN OR PERFORATION MATERIAL:
 1 Steel 3 Stainless steel 5 Fiberglass 8 RMP (SR) 10 Asbestos-cement
 2 Brass 4 Galvanized steel 6 Concrete tile 9 ABS 11 Other (specify)
 12 None used (open hole)

SCREEN OR PERFORATION OPENINGS ARE:
 1 Continuous slot 3 Mill slot 5 Gauzed wrapped 8 Saw cut 11 None (open hole)
 2 Louvered shutter 4 Key punched 6 Wire wrapped 9 Drilled holes
 7 Torch cut 10 Other (specify)

SCREEN-PERFORATED INTERVALS: From 10 ft. to 15 ft., From 67 ft. to 72 ft.
 GRAVEL PACK INTERVALS: From 10 ft. to 50 ft., From 55 ft. to 72 ft.

6 GROUT MATERIAL: 1 Neat cement 2 Cement grout 3 Bentonite 4 Other
 Grout intervals: From 1 ft. to 10 ft., From 50 ft. to 55 ft., From 72 ft. to 77 ft.

What is the nearest source of possible contamination:
 1 Septic tank 4 Lateral lines 7 Pit privy 10 Livestock pens 14 Abandoned water well
 2 Sewer lines 5 Cess pool 8 Sewage lagoon 11 Fuel storage 15 Oil well/Gas well
 3 Watertight sewer lines 6 Seepage pit 9 Feedyard 12 Fertilizer storage 16 Other (specify below)
 13 Insecticide storage

Direction from well? South How many feet? 200

FROM	TO	LITHOLOGIC LOG	FROM	TO	LITHOLOGIC LOG
0	10	Top soil			
10	20	Clay and sand streaks			
20	25	Fine sand			
25	30	Sandy clay			
30	40	Sandy clay			
40	50	Fine sand			
50	60	Fine sand			
60	70	Fine sand			
70	80	Fine sand			

7 CONTRACTOR'S OR LANDOWNER'S CERTIFICATION: This water well was (1) constructed, (2) reconstructed, or (3) plugged under my jurisdiction and was completed on (mo/day/year) Dec. 11, 1983 and this record is true to the best of my knowledge and belief. Kansas Water Well Contractor's License No. 245 This Water Well Record was completed on (mo/day/yr) 3-21-84 under the business name of Western Well & Pump, Inc. by (signature) Roy F. Senor

INSTRUCTIONS: Use typewriter or ball point pen, PLEASE PRESS FIRMLY and PRINT clearly. Please fill in blanks, underline or circle the correct answers. Send top three copies to Kansas Department of Health and Environment, Division of Environment, Environmental Geology Section, Topeka, KS 66620. Send one to WATER WELL OWNER and retain one for your records.

OFFICE USE ONLY

T

28

R

25

EW

SEC.

23

1/4

1/4

SE