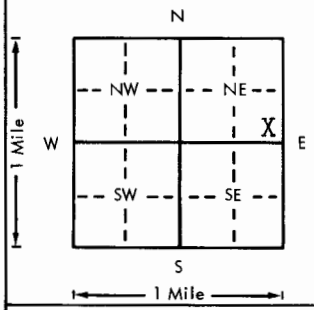


USE TYPEWRITER OR BALL  
POINT PEN-PRESS FIRMLY,  
PRINT CLEAR!

WATER WELL RECORD  
KSA 82a-1201-1215

Kansas Department of Health and  
Environment-Division of Environment  
(Water well Contractors)  
Topeka, Kansas 66620

1. Location of well:		County <b>Ford</b>	Fraction <b>SE 1/4 SE 1/4 NE 1/4</b>	Section number <b>23</b>	Township number <b>T 28 S R 25</b>	Range number <b>E XX</b>
2. Distance and direction from nearest town or city: <b>9 1/4 S, 1/4 W of Dodge City on 283</b> Street address of well location if in city:				3. Owner of well: <b>Dwight Winger</b> R.R. or street: City, state, zip code: <b>Dodge City, KS 67801</b>		
4. Locate with "X" in section below:		Sketch map:		6. Bore hole dia. <b>28</b> in. Completion date _____ Well depth <b>275</b> ft. <b>1-17-77</b>		
				7. <input type="checkbox"/> Cable tool <input type="checkbox"/> Rotary <input type="checkbox"/> Driven <input type="checkbox"/> Dug <input type="checkbox"/> Hollow rod <input type="checkbox"/> Jetted <input type="checkbox"/> Bored <input checked="" type="checkbox"/> Reverse rotary		
5. Type and color of material				From	To	8. Use: <input type="checkbox"/> Domestic <input type="checkbox"/> Public supply <input type="checkbox"/> Industry <input checked="" type="checkbox"/> Irrigation <input type="checkbox"/> Air conditioning <input type="checkbox"/> Stock <input type="checkbox"/> Lawn <input type="checkbox"/> Oil field water <input type="checkbox"/> Other
Surface				0	2	9. Casing: Material <b>steel</b> Height: Above or below Threaded _____ Welded <input checked="" type="checkbox"/> Surface <b>12</b> in. RMP _____ PVC _____ Weight _____ lbs./ft.
Clay				2	61	Dia. <b>16</b> in. to <b>0</b> ft. depth Wall Thickness: inches or Dia. <b>16</b> in. to <b>115</b> ft. depth gage No. <b>188</b>
Clay & Caliche				61	88	10. Screen: Manufacturer's name _____ <b>W. A. Brown</b> Type <b>Bridge</b> Dia. <b>16"</b> Slot/gauze <b>17% .188</b> Length <b>40-160</b> Set between <b>115</b> ft. and <b>275</b> ft. Gravel pack? <input checked="" type="checkbox"/> Size range of material <b>1/4x5/8</b>
Sand				88	91	11. Static water level: _____ mo./day/yr. <b>71</b> ft. below land surface Date <b>1-17-77</b>
Clay & Caliche				91	100	12. Pumping level below land surfaces: <b>126</b> ft. after <b>3</b> hrs. pumping <b>1400</b> g.p.m. _____ ft. after _____ hrs. pumping _____ g.p.m. Estimated maximum yield <b>2000</b> g.p.m.
Sand				100	103	13. Water sample submitted: _____ mo./day/yr. Yes <input checked="" type="checkbox"/> No <input type="checkbox"/> Date _____
Clay & Caliche				103	115	14. Well head completion: _____ <input type="checkbox"/> Pitless adapter <b>12</b> Inches above grade
Medium Sand & Gravel				115	130	15. Well grouted? <input checked="" type="checkbox"/> With: <input type="checkbox"/> Neat cement <input type="checkbox"/> Bentonite <input checked="" type="checkbox"/> Concrete Depth: From <b>0</b> ft. to <b>10</b> ft.
Clay & Caliche				130	138	16. Nearest source of possible contamination: ft. _____ mile Direction <b>North</b> Type <b>Mulberry Creek</b> Well disinfected upon completion? _____ Yes <input checked="" type="checkbox"/> No <input type="checkbox"/>
Clay & Caliche				138	148	17. Pump: _____ Not installed Manufacturer's name <b>WLR</b> Model number <b>5014CH</b> HP <b>200</b> Volts _____ Length of drop pipe <b>200</b> ft. capacity <b>1400</b> g.p.m. Type: _____ <input type="checkbox"/> Submersible <input checked="" type="checkbox"/> Turbine <input type="checkbox"/> Jet <input type="checkbox"/> Reciprocating <input type="checkbox"/> Centrifugal <input type="checkbox"/> Other
Sand				148	150	
Clay				150	159	
Sand				159	161	
Clay				161	165	
Sand				165	166	
Clay				166	166	
(Use a second sheet if needed)						
18. Elevation:		19. Remarks:		20. Water well contractor's certification: This well was drilled under my jurisdiction and this report is true to the best of my knowledge and belief. <b>Woofert Drilling, Inc. 343</b> Business name _____ License No. _____ Address <b>HWY. 560 Dodge City, KS</b> Signed <b>Michael Woofert</b> Date <b>9/6/77</b> Authorized representative		

USE TYPEWRITER OR BALL  
POINT PEN-PRESS FIRMLY,  
PRINT CLEARLY.

WATER WELL RECORD  
KSA 82a-1201-1215

Page 2--Dwight Winger

Kansas Department of Health and  
Environment--Division of Environment  
(Water well Contractors)  
Topeka, Kansas 66620

1. Location of well:		County	Fraction 1/4 1/4 1/4	Section number	Township number T S R	Range number E/W
2. Distance and direction from nearest town or city: Street address of well location if in city:				3. Owner of well: R.R. or street: City, state, zip code:		
4. Locate with "X" in section below: N 1 Mile W E S 1 Mile				Sketch map: 6. Bore hole dia. _____ in. Completion date _____ Well depth _____ ft. 7. _____ Cable tool _____ Rotary _____ Driven _____ Dug _____ Hollow rod _____ Jetted _____ Bored _____ Reverse rotary 8. Use: _____ Domestic _____ Public supply _____ Industry _____ Irrigation _____ Air conditioning _____ Stock _____ Lawn _____ Oil field water _____ Other 9. Casing: Material _____ Height: Above or below Threaded _____ Welded _____ Surface _____ in. RMP _____ PVC _____ Weight _____ lbs./ft. Dia. _____ in. to _____ ft. depth Wall Thickness: inches or Dia. _____ in. to _____ ft. depth gage No. _____		
5. Type and color of material				From	To	10. Screen: Manufacturer's name _____ Type _____ Dia. _____ Slot/gauze _____ Length _____ Set between _____ ft. and _____ ft. _____ ft. and _____ ft. Gravel pack? _____ Size range of material _____
Medium Sand & Gravel				166	180	11. Static water level: _____ mo./day/yr. _____ ft. below land surface Date _____
Clay				180	189	12. Pumping level below land surfaces: _____ ft. after _____ hrs. pumping _____ g.p.m. _____ ft. after _____ hrs. pumping _____ g.p.m. Estimated maximum yield _____ g.p.m.
Sand & Gravel				189	193	13. Water sample submitted: _____ mo./day/yr. _____ Yes _____ No Date _____
Clay & Caliche				193	199	14. Well head completion: _____ Pitless adapter _____ Inches above grade
Medium Fine Sand				199	203	15. Well grouted? _____ With: _____ Neat cement _____ Bentonite _____ Concrete Depth: From _____ ft. to _____ ft.
Clay				203	217	16. Nearest source of possible contamination: ft. _____ Direction _____ Type _____ Well disinfected upon completion? _____ Yes _____ No
Fine Sand				217	226	17. Pump: _____ Not installed Manufacturer's name _____ Model number _____ HP _____ Volts _____ Length of drop pipe _____ ft. capacity _____ g.p.m. Type: _____ Submersible _____ Turbine _____ Jet _____ Reciprocating _____ Centrifugal _____ Other
Clay				226	227	
Fine Sand				227	230	
Clay				230	240	
Sand Rock				240	247	
Sand Rock & Clay Layers				247	255	
Sand Rock				255	270	
Clay				270	300	
(Use a second sheet if needed)						
18. Elevation:		19. Remarks:		20. Water well contractor's certification: This well was drilled under my jurisdiction and this report is true to the best of my knowledge and belief. Woofter Drilling, Inc. 343 Business name _____ License No. _____ Address _____ Hwy. 56, Dodge City, KS Signed _____ Date 9/6/72 Authorized representative		
Topography: _____ Hill _____ Slope _____ Upland _____ Valley						