

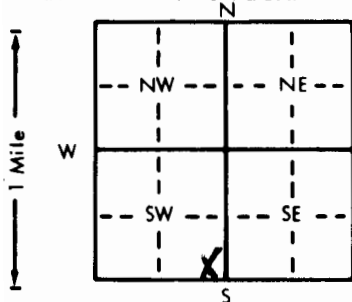
1 LOCATION OF WATER WELL: County: <b>Ford</b>	Fraction <b>SE 1/4 SE 1/4 SW 1/4</b>	Section Number <b>29</b>	Township Number <b>T 28 S</b>	Range Number <b>R 25 E/W</b>
--	---	-----------------------------	----------------------------------	---------------------------------

Distance and direction from nearest town or city street address of well if located within city?

**10 South 2 West Dodge City, KS**

2 WATER WELL OWNER: <b>Myron Nicholson</b> RR#, St. Address, Box # <b>RR 1</b> City, State, ZIP Code <b>Dodge City, KS 67801</b>	Board of Agriculture, Division of Water Resources Application Number:
--	--

3 LOCATE WELL'S LOCATION WITH AN "X" IN SECTION BOX:	4 DEPTH OF COMPLETED WELL <b>140</b> ft. ELEVATION:
--	---

Depth(s) Groundwater Encountered **112 MIA** ft. 2. ft. 3. ft.WELL'S STATIC WATER LEVEL **MIA** ft. below land surface measured on mo/day/yrPump test data: Well water was **MIA** ft. after hours pumping gpm  
Est. Yield **20** gpm Well water was ft. after hours pumping gpm  
Bore Hole Diameter **9** in. to ft. and in. to ft.WELL WATER TO BE USED AS: 5 Public water supply 8 Air conditioning 11 Injection well  
1 Domestic 3 Feedlot 6 Oil field water supply 9 Dewatering 12 Other (Specify below)  
2 Irrigation 4 Industrial 7 Lawn and garden only 10 Observation wellWas a chemical/bacteriological sample submitted to Department? Yes No **X**; If yes, mo/day/yr sample was submitted Water Well Disinfected? Yes **X** No

5 TYPE OF BLANK CASING USED:	5 Wrought iron	8 Concrete tile	CASING JOINTS: Glued <b>X</b> Clamped
1 Steel	3 RMP (SR)	6 Asbestos-Cement	9 Other (specify below)
<b>2 PVC</b>	4 ABS	7 Fiberglass	10 Asbestos-cement

Blank casing diameter **5** in. to **120** ft., Dia. in. to ft., Dia. in. to ft.  
Casing height above land surface **15** in., weight **250** lbs./ft. Wall thickness or gauge No. **250**

TYPE OF SCREEN OR PERFORATION MATERIAL:	1 Steel	3 Stainless steel	5 Fiberglass	8 RMP (SR)	11 Other (specify)
2 Brass	4 Galvanized steel	6 Concrete tile	9 ABS	12 None used (open hole)	

SCREEN OR PERFORATION OPENINGS ARE:	5 Gauzed wrapped	8 Saw cut	11 None (open hole)
1 Continuous slot	3 Mill slot	6 Wire wrapped	9 Drilled holes
2 Louvered shutter	4 Key punched	7 Torch cut	10 Other (specify)

SCREEN-PERFORATED INTERVALS:	From <b>120</b> ft. to <b>140</b> ft.	From ft. to ft.
GRAVEL PACK INTERVALS:	From <b>140</b> ft. to <b>20</b> ft.	From ft. to ft.

6 GROUT MATERIAL:	1 Neat cement	2 Cement grout	3 Bentonite	4 Other
-------------------	---------------	----------------	-------------	---------

Grout Intervals: From **0** ft. to **20** ft., From ft. to ft., From ft. to ft.  
What is the nearest source of possible contamination:  
**1** Septic tank 4 Lateral lines 7 Pit privy 10 Livestock pens 14 Abandoned water well  
2 Sewer lines 5 Cess pool 8 Sewage lagoon 11 Fuel storage 15 Oil well/Gas well  
3 Watertight sewer lines 6 Seepage pit 9 Feedyard 12 Fertilizer storage 16 Other (specify below)  
13 Insecticide storageDirection from well? **100** How many feet? **SW**

FROM	TO	LITHOLOGIC LOG	FROM	TO	LITHOLOGIC LOG
<b>0</b>	<b>3</b>	<b>Topsoil</b>			
<b>3</b>	<b>60</b>	<b>clay</b>			
<b>60</b>	<b>95</b>	<b>DRY SAND</b>			
<b>95</b>	<b>108</b>	<b>clay</b>			
<b>108</b>	<b>138</b>	<b>GRAVEL</b>			
<b>138</b>	<b>140</b>	<b>clay</b>			

7 CONTRACTOR'S OR LANDOWNER'S CERTIFICATION: This water well was <b>(1)</b> constructed, (2) reconstructed, or (3) plugged under my jurisdiction and was completed on (mo/day/year) <b>5-25-83</b> and this record is true to the best of my knowledge and belief. Kansas Water Well Contractor's License No. <b>111</b> This Water Well Record was completed on (mo/day/yr) <b>5-26-83</b>
---

under the business name of **Cragg Drilling** by (signature) **Kay Dring**

INSTRUCTIONS: Use typewriter or ballpoint pen, PLEASE PRESS FIRMLY and PRINT clearly. Please fill in blanks, underline or circle the correct answers. Send top three copies to Kansas Department of Health and Environment, Division of Environment, Environmental Geology Section, Topeka, KS 66620. Send one to WATER WELL OWNER and retain one for your records.