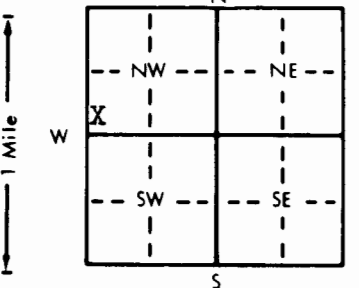


| | | | | | |
|--|-----|--|----------------|--------------------------|--------------------|
| 1 LOCATION OF WATER WELL: | | Fraction | Section Number | Township Number | Range Number |
| County: Ford | | SW 1/4 SW 1/4 NW 1/4 | 36 | T 28 S | R 25 E/W |
| Distance and direction from nearest town or city street address of well if located within city? 11 South of Dodge City on HWY 283 | | | | | |
| 2 WATER WELL OWNER: | | Board of Agriculture, Division of Water Resources | | | |
| RR#, St. Address, Box # : | | Application Number: --- | | | |
| City, State, ZIP Code : | | Dodge City, KS 67801 | | | |
| 3 LOCATE WELL'S LOCATION WITH AN "X" IN SECTION BOX: | | 4 DEPTH OF COMPLETED WELL: 200 ft. ELEVATION: Slope | | | |
|  | | Depth(s) Groundwater Encountered 1. Not available 2. ft. 3. ft. | | | |
| | | WELL'S STATIC WATER LEVEL 142 ft. below land surface measured on mo/day/yr April 2, 1990 | | | |
| | | Pump test data: Well water was ft. after hours pumping gpm | | | |
| | | Est. Yield gpm: Well water was ft. after hours pumping gpm | | | |
| Bore Hole Diameter 10 in. to 200 ft. and in. to ft. | | WELL WATER TO BE USED AS: | | | |
| 5 Public water supply | | 8 Air conditioning | | 11 Injection well | |
| XXX Domestic | | 3 Feedlot | | 6 Oil field water supply | |
| 2 Irrigation | | 4 Industrial | | 9 Dewatering | |
| 7 Lawn and garden only | | 10 Monitoring well | | 12 Other (Specify below) | |
| Was a chemical/bacteriological sample submitted to Department? Yes No XX If yes, mo/day/yr sample was submitted | | | | | |
| Water Well Disinfected? Yes XX No | | | | | |
| 5 TYPE OF BLANK CASING USED: | | | | | |
| 1 Steel | | 3 RMP (SR) | | 5 Wrought iron | |
| XX PVC | | 4 ABS | | 6 Asbestos-Cement | |
| 7 Fiberglass | | 8 Concrete tile | | 9 Other (specify below) | |
| CASING JOINTS: Glued XX Clamped | | | | | |
| Welded | | | | | |
| Threaded | | | | | |
| Blank casing diameter 5 in. to 160 ft., Dia in. to ft., Dia in. to ft. | | | | | |
| Casing height above land surface 18 in., weight 2.8 lbs./ft. Wall thickness or gauge No. 265 | | | | | |
| TYPE OF SCREEN OR PERFORATION MATERIAL: | | | | | |
| 1 Steel | | 3 Stainless steel | | XX PVC | |
| 2 Brass | | 4 Galvanized steel | | 10 Asbestos-cement | |
| 5 Fiberglass | | 8 RMP (SR) | | 11 Other (specify) | |
| 6 Concrete tile | | 9 ABS | | 12 None used (open hole) | |
| SCREEN OR PERFORATION OPENINGS ARE: | | | | | |
| 1 Continuous slot | | 3 Mill slot | | XX Saw cut | |
| 2 Louvered shutter | | 4 Key punched | | 11 None (open hole) | |
| 5 Gauzed wrapped | | 6 Wire wrapped | | 9 Drilled holes | |
| 7 Torch cut | | 10 Other (specify) | | | |
| SCREEN-PERFORATED INTERVALS: From 5 ft. to 160 ft., From 200 ft. to ft. | | | | | |
| From ft. to ft., From ft. to ft. | | | | | |
| GRAVEL PACK INTERVALS: From 20 ft. to 140 ft., From ft. to ft. | | | | | |
| From 150 ft. to 200 ft., From ft. to ft. | | | | | |
| 6 GROUT MATERIAL: | | | | | |
| 1 Neat cement | | 2 Cement grout | | 3 Bentonite | |
| XX Other Baroid Hole Plug | | | | | |
| Grout Intervals: From 0 ft. to 20 ft., From 140 ft. to 150 ft., From ft. to ft. | | | | | |
| What is the nearest source of possible contamination: NONE | | | | | |
| 1 Septic tank | | 4 Lateral lines | | 7 Pit privy | |
| 2 Sewer lines | | 5 Cess pool | | 8 Sewage lagoon | |
| 3 Watertight sewer lines | | 6 Seepage pit | | 9 Feedyard | |
| 10 Livestock pens | | 14 Abandoned water well | | 15 Oil well/Gas well | |
| 11 Fuel storage | | 12 Fertilizer storage | | 16 Other (specify below) | |
| 13 Insecticide storage | | | | | |
| Direction from well? How many feet? | | | | | |
| FROM | TO | LITHOLOGIC LOG | FROM | TO | PLUGGING INTERVALS |
| 0 | 3 | Topsoil | | | |
| 3 | 91 | Clay | | | |
| 91 | 102 | Fine Sand | | | |
| 102 | 131 | Clay | | | |
| 131 | 140 | Med. to Lar. Sand | | | |
| 140 | 162 | Clay | | | |
| 162 | 200 | Med. to Lar. Sand & Gravel | | | |
| 7 CONTRACTOR'S OR LANDOWNER'S CERTIFICATION: This water well was (1) constructed, (2) reconstructed, or (3) plugged under my jurisdiction and was completed on (mo/day/year) April 2, 1990 and this record is true to the best of my knowledge and belief. Kansas Water Well Contractor's License No. 252 This Water Well Record was completed on (mo/day/year) April 16, 1990 under the business name of Friesen Windmill & Supply Inc. by (signature) <i>[Signature]</i> | | | | | |