


WATER WELL RECORD Form WWC-5 KSA 82a-1212

1 LOCATION OF WATER WELL: Fraction Section Number Township Number Range Number
 COUNTY: 029 FORD SW 1/4 NE 1/4 NE 1/4 22 T 28 S R 25 W

Distance and direction from nearest town or city street address of well if located within city?
 APPROX. 8 3/4 MILES SOUTH AND 1/4 WEST OF DODGE CITY

2 WATER WELL OWNER: FARMLAND NATIONAL BEEF
 RR#, St. Address, Box # : 2000 E TRAIL PO BOX 539 Board of Agriculture, Division of Water Resources
 City, State, ZIP code : DODGE CITY, KS 67801-0539 Application Number: 23133

3 LOCATE WELL'S LOCATION WITH AN "X" IN SECTION BOX:

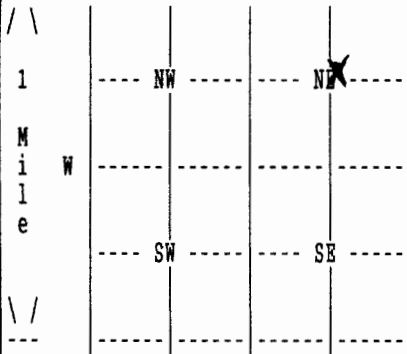

4 DEPTH OF COMPLETED WELL 195 ELEVATION: 0
 Depth(s) Groundwater Encountered 1. 0 ft. 2. 0 ft. 3. 0 ft.

WELL'S STATIC WATER LEVEL 114 ft. below land surface measured on mo/day/yr 02/02/06
 Pump test data: Well water was 0 ft. after 0 hours pumping 0 gpm

Estimated Yield 0 gpm: Well water was 0 ft. after 0 hours pumping 0 gpm

Bore Hole Diameter in. to 0 ft., and in. to 0 ft.

WELL WATER WAS: 02 IRRIGATION

Was a chemical/bacteriological sample submitted to department? No ;
 If yes, mo/day/yr sample was submitted Water well disinfected? Yes

5 TYPE OF BLANK CASING USED: 01 STEEL CASING JOINTS: WELDED
 Blank casing diameter 16 in. to 195 ft., Dia in. to 0 ft., Dia in. to 0 ft.
 Casing height above land surface -48 in., weight 0 lbs/ft. Wall thickness or gauge No.
 TYPE OF SCREEN OR PERFORATION MATERIAL: 01 STEEL
 SCREEN OR PERFORATION OPENINGS ARE: OTHER - PUNCHED

SCREEN PERFORATED INTERVALS: From 5 ft. to 100 ft., From 0 ft. to 0 ft.
 From 0 ft. to 0 ft., From 0 ft. to 0 ft.
 GRAVEL PACK INTERVALS: From 0 ft. to 0 ft., From 0 ft. to 0 ft.
 From 0 ft. to 0 ft., From 0 ft. to 0 ft.

6 GROUT MATERIAL 02 CEMENT GROUT
 Grout Intervals: From 5 ft. to 100 ft., From 0 ft. to 0 ft., From 0 ft. to 0 ft.
 What is the nearest source of possible contamination: NONE OBSERVED
 Direction from well? How many feet? 0

FROM	TO	LITHOLOGIC LOG	FROM	TO	PLUGGING INTERVALS
			0	5	BACKFILL
			5	100	CEMENT
			100	195	GRAVEL
			0	0	
			0	0	
			0	0	
			0	0	
			0	0	
			0	0	
			0	0	

7 CONTRACTOR'S OR LANDOWNER'S CERTIFICATION: This water well was Plugged under my jurisdiction and was completed on (mo/day/year) 02/02/06 and this record is true to the best of my knowledge and belief. Kansas
 Water Well Contractor's License No. 145 This Water Well Record was completed on (mo/day/yr) 03/29/06
 under the business name of HENKLE DRILLING & SUPPLY by (signature) *Bruce J. Reichert*